


CERTIFIED RECORD OF LAND CORNER MONUMENTATION

History of original corner establishment:

This corner was originally set in 1883 under U.S. General Land Office Contract No. 475 by Rufus Moore, Deputy Surveyor, who set a 18" x 8" x 4" Basalt stone from which:

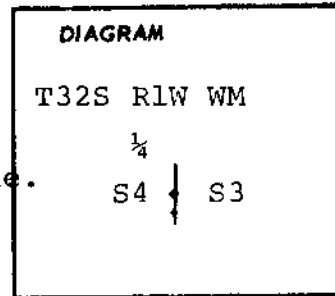

A live Oak, 4" diameter, bears N 82° E, 34 links distance, marked 1/4 S BT.

A Matherone, 14" diameter, bears N 65° W, 4 links distance, marked 1/4 S BT. The corner was renewed by Art Boyer in 1949. Boyer marked the following bearing trees:

A 3" Live Oak, bears N 82° E, 34 links (Boyer's Record 34.0 feet) growing out of the decayed original Oak BT, marked "1/4 S3 BT 1581"
A 12" Oak bears N 76° E, 4.5 feet, marked "1/4 S3 BT 1581"

DESCRIPTION OF CORNER EVIDENCE FOUND:

24" Madrone, original BT, with scribe marks "1/4" visible on a partially rotted blaze bears N 65° W, 2.6 feet. (Boyer's Record 4.0 feet)

4" live Oak, with scribe marks "1/4 S3" visible on an opened blaze bears, N 82° E, 15.8 feet (Boyer's Record 34.0 feet)


12" live Oak, with scribe marks "1/4 S3 BT 1581" visible on a rotted blaze bears, N 84° E, 5.0 feet (Boyer's Record N 76° E, 4.5 feet)

Description of monument and accessories I established to perpetuate the original location of this corner

At the corner point:

Set a 2" x 30" iron pipe, 12" in the ground on solid rock, in a 3 foot diameter mound of stone with a 3" brass cap marked:

T32S RLW
1/4
S4 | S3
1979 PLS 536

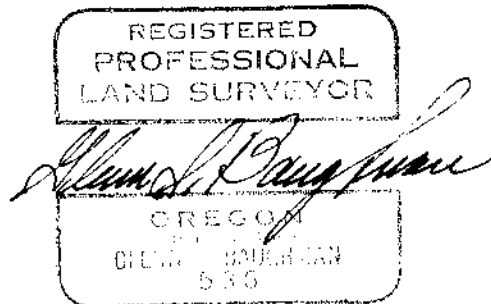

Compass declination 20° East.

Office of Surveyor County of Douglas State of Oregon, I hereby certify that the within instrument was filed in this office for record on the 26 day of September, 1979, at 4 o'clock P.M., (signed) Francis L. Ingram by Virginia J. Gausman (DEPUTY)

RECEIVED JR

SEP 27 1979

CHIEF SURVEYOR
DOUGLAS COUNTY, ORE.

#2

#80 x