

CERTIFIED RECORD OF LAND CORNER MONUMENTATION

#23
T 25-1W

History of original corner establishment:


G.L.O. July 15, 1896

Set-Basalt Stone 12"x10"x10"
24" Fir S17°E 19 lks "1/4 S. BT"
48" Fir S27°W 31 lks "1/4 S. BT"

G.L.O. 1927

Found - Basalt Stone 6"x10"x10"
30" Fir S17°E 19 lks
40" Fir S27°W 31 lks

Set -12" Cedar N42°W 18 lks "1/4 S 13, BT"

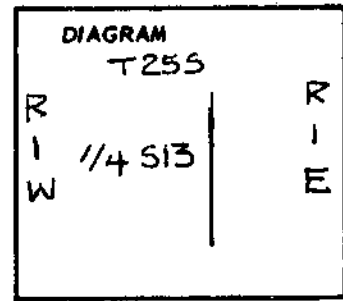

G.R. Lecklider August 1960

Found - 48" Fir S27°W 20.5 ft
12" Cedar N42°W 56.2 ft

Set - Steel tube with survey cap.

Description of corner evidence found:

5/8" steel tube buried 12" under the berm at the side of a skid trail.

1" Aluminum cap attached marked "Property Corner."

From which: 36" D. Fir stump with axe marks in bark bears S26°-55'W, 20.8 ft.

12" Cedar stump cut approx. 36" high with face charred from slash fire bears N44°-05'W, 55.8 ft.


FILED
RECEIVED *JK*

NOV 20 1978

COUNTY SURVEYOR
DOUGLAS COUNTY, ORE.

Description of monument and accessories I established to perpetuate the original location of this corner

Replaced tube with 2"x30" galvanized steel pipe 26" in the ground. Planted tube next to pipe. Marked the attached 2 1/2" brass cap as shown below. Scribed 15" Cedar "1/4 S 13, BT" and attached brass washer marked "L.S. 866", bears S20°55'W, 77.8 ft. Drove green 6' steel fence post 18" into the ground and painted red. Bears N45°56'W, 55.8 ft. Constructed mound of stones around the 2"x30" steel pipe.

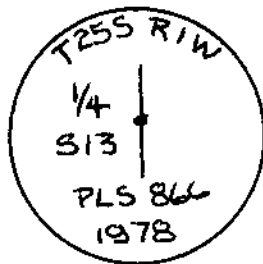

REGISTERED
OREGON
LAND SURVEYOR

William J. Ruppert
JULY 12, 1988
WILLIAM J. RUPPERT
866

Office of _____ Surveyor _____ County of _____ Douglas _____
State of _____ Oregon _____

_____, I hereby certify that the within instrument was filed in this office for record on the 20th day of _____ November _____, 1978, at 12 o'clock p.m. (signed)

Francis L. Ingram _____ by *Virginia A. Langens* _____
(COUNTY OFFICIAL) (DEPUTY)

#35 T 25-1E ✓
#143 T 25-1W ✓
Form R6-7100-57 (9/66)

C
S. File No. 50/176-12
A