

**CERTIFIED RECORD OF LAND CORNER MONUMENTATION**


T-512  
#12  
#77 T25-1W

**History of original corner establishment:**

G.L.O. 1927  
Set - Iron Post  
8" Fir N61°E 46 lks "T25S R1E S18 CC,BT"  
8" Fir S40°E 42 lks "T25S R1E S19 CC,BT"

G.R. Lecklider 1958  
Found - Brass Cap 8" Fir N51°E 30.4 ft  
8" Fir S40°E 27.7 ft


Douglas County Surveyor 1966  
Found - 1927 G.L.O. Brass cap 11" Fir snag N61°E 30.4 ft  
10" Fir snag S40°E 27.7 ft  
Marked 36" Cedar S28°E 7.4 ft "T25S R1E S19,CC CS, BT"  
13" D. Fir N1°E 31.6 ft "T25S R1E S 18,CC CS,BT"

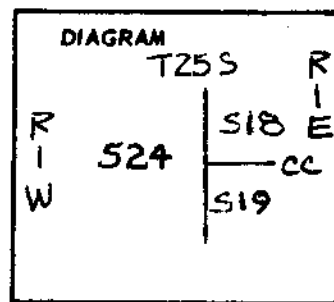

**Description of corner evidence found:**

2" Iron Pipe with 2½" Brass Cap marked as shown

30" Cedar snag S28°E, 6.4 ft  
9" D. Fir snag S40°E, 27.7 ft

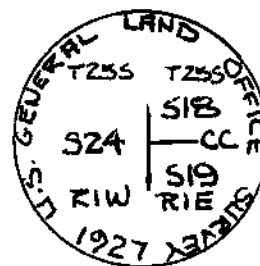

**Description of monument and accessories established to perpetuate the original location of this corner**

15" D. Fir Blazed & scribed "T25S R1E S19 CC,BT" with Brass washer marked "LS 866" attached S07°30'E, 31.3 ft  
10" D. Fir Blazed & scribed "T25S R1E S18 CC,BT" with Brass washer marked "LS 866" attached N77°00'E, 80.5 ft.

FILED  
RECEIVED *JK*

NOV 20 1976

COUNTY SURVEYOR  
DOUGLAS COUNTY, ORE.

REGISTERED  
OREGON  
LAND SURVEYOR

*William J. Ruppert*  
JULY 12, 1968  
WILLIAM J. RUPPERT  
866

Office of ..... Surveyor ..... County of ..... Douglas .....  
State of ..... Oregon ..... , I hereby certify that the within instrument was filed in this office  
for record on the 20th day of November ..... , 1978, at 12 o'clock P.M. (signed)  
Francis L. Ingram ..... by *Virginia A. Hansen*  
(COUNTY OFFICIAL) (DEPUTY)

#144 - T25-1WX  
#34 T25-1E X