

**CERTIFIED RECORD OF LAND CORNER MONUMENTATION**

# 18  
# 20  
# 13 T25-15


**History of original corner establishment:**

G.L.O July 15, 1896  
 Set - 14x12x6 ins. Basalt stone  
     16" Fir N58°E, 20 lks "WC T25S R1E S7 BT"  
     36" Fir N89°W, 20 lks "WC T25S R1W S12 BT"

G.L.O. 1927  
 Found Stone, remarked W.C.S12 on N.W. & S13 on S.W. Face  
     20" Fir, N58°E 20 lks Marks destroyed  
     40" Fir N89°W 20 lks  
 Set 30" Fir, S24°W 48 lks

G.R. Lecklider Aug. 1960  
 Found 30" Fir S24°W 31.7 ft  
     40" Fir N89°W 13.2 ft

County Surveyor Nov. 1966

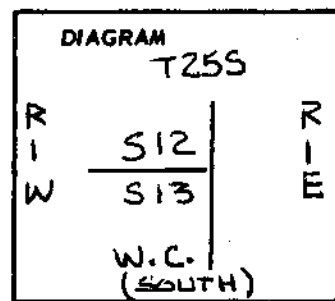

Found Rock 1.3 ft north of CC Secs. 7 and 18, T25S,R1E  
 40" Fir snag N89°W 13.2 ft (slope)  
 34" Fir S24°W 31.7 ft  
 20" Fir snag N58°E 13.2 ft

Marked- 12" Cedar S71°W 40.3 ft  
 12" Pine N14°W 106.3 ft

Description of corner evidence found:

Found - 39" D. Fir N87°06'W, 13.2 ft with good scar  
 33" D. Fir stump S25°04'W, 31.7 ft scribing partially visible  
 11" Cedar S73°12'W, 39.9 ft scribing partially visible  
 12" Pine N14°08'W, 107.9 ft with good scar

**Description of monument and accessories I established to perpetuate the original location of this corner**


I set a 2"x30" galvanized steel pipe 24" into the ground and constructed a mound of stones around it. I marked the attached 2½" Brass cap as shown.

FILED  
 RECEIVED *WJ*

NOV 20 1978

COUNTY SURVEYOR  
 DOUGLAS COUNTY, ORE.

REGISTERED  
 OREGON  
 LAND SURVEYOR  
*William J. Ruppert*  
 JULY 12, 1966  
 WILLIAM J. RUPPERT  
 866

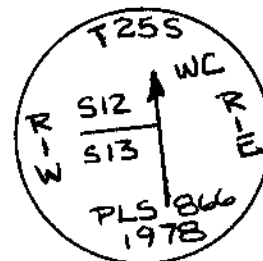

Office of \_\_\_\_\_ Surveyor \_\_\_\_\_ County of Douglas  
 State of Oregon \_\_\_\_\_, I hereby certify that the within instrument was filed in this office  
 for record on the 20th day of November, 1978, at 12 o'clock P.M., (signed)  
 Francis L. Ingram by *Virginia A. Langer*  
 (COUNTY OFFICIAL) (DEPUTY)

# 33 T25-1E ✓  
 # 145 T25-1W ✓