

CERTIFIED RECORD OF LAND CORNER MONUMENTATION


History of original corner establishment:

G.L.O. 1927

Set - Iron Post with Brass Cap
 30" Fir N24°E 137 lks
 16" Fir S37½°E 151 lks

G.R. Lecklider Aug. 1960

Found - Brass Cap
 32" Fir N24°E 90.4 ft
 20" Fir S37½°E 99.7 ft

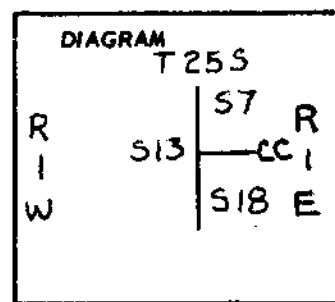

FILED
 RECEIVED *W*


NOV 20 1978

COUNTY SURVEYOR
 DOUGLAS COUNTY, ORE.

Description of corner evidence found:

1½" Pipe with 2½" Brass cap marked as shown
 Both had slid several feet down hill with pile of stones

38" D. Fir N23°49'E, 90.5 ft Shows good scar
 22" D. Fir S36°06'E, 97.3 ft Shows good scar

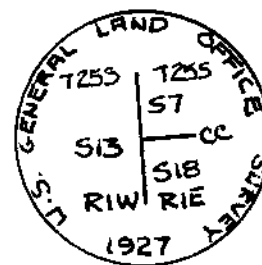

Description of monument and accessories established to perpetuate the original location of this corner

I reset original pipe with brass cap S00°58'E, 1.32 ft from the pipe I had previously set for the witness corner to the corner of Sections 12 and 13. I constructed a mound of stones around it.

REGISTERED
 OREGON
 LAND SURVEYOR

William J. Ruppert
 JULY 12, 1968
 WILLIAM J. RUPPERT
 866

Office of Surveyor County of Douglas
 State of Oregon
 I hereby certify that the within instrument was filed in this office
 for record on the 20th day of November, 1978, at 12 o'clock p.m., (signed)
 Francis L. Ingram by *Virginia A. Saugen*
 (COUNTY OFFICIAL) (DEPUTY)

#36 - 25-1E X
 #142 T 25-1W X