

CERTIFIED RECORD OF LAND CORNER MONUMENTATION

History of original corner establishment: The corner was originally established in 1894 under Contract No. 620, by William M. Bushey, Deputy Surveyor, who set a 15x6x6 in. stone marked 1/4 on the West face; from which:


A laurel, 9" diam, bears S 88 1/2° W, 66 1/2 lks. dist, mkd. 1/4 S, BT.

A laurel, 10" diam, bears S 77° E, 48 lks. dist, mkd. 1/4 S, BT.

The corner was renewed in 1960 by Robert M. Thompson who set a 1" iron pipe at single proportionate distance, and marked new bearing trees:

A Douglas Fir, 11" diam, bears S 33°20' W, 14.1 ft.

A Douglas Fir, 12" diam, bears N 64°45' E, 18.4 ft.

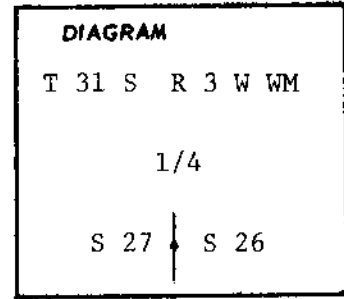

Description of corner evidence found:

A 1" iron pipe, firmly set, from which bearing trees marked by Thompson:

A Douglas Fir, 16" diam, with healed double blaze, bears S 33 1/4° W, 14.5 ft. (Record 14.1')

A Twin Douglas Fir, 16" diam, with healed double balze, bears N 64 3/4° E, 18.4 ft.

Description of monument and accessories established to perpetuate the original location of this corner

Set a 2" x 32" iron pipe, 20" in the ground with a 3" Brass Cap marked:

FILED
RECEIVED

DEC 4 1979

COUNTY SURVEYOR
DOUGLAS COUNTY, ORE

T 31 S R 3 W
1/4
S 27 | S 26
1979 PLS 536

REGISTERED
PROFESSIONAL
LAND SURVEYOR

Glenn S. Baughman
OREGON
JULY 14 1961
GLENN S. BAUGHMAN
536

Compass declination: 20° East

Office of Surveyor County of Douglas
State of Oregon, I hereby certify that the within instrument was filed in this office
for record on the 4th day of December, 1979, at 4:15'clock P.m., (signed)
Francis L. Ingram by *Virginia A. Fungon*
(COUNTY OFFICIAL) (DEPUTY)

#213 X

C