


CERTIFIED RECORD OF LAND CORNER MONUMENTATION

History of original corner establishment: The corner was originally established in 1893 by William M. Bushey, Deputy Surveyor, under Contract No. 620, who set a 15x10x6" stone marked 1/4 on the West face, from which:

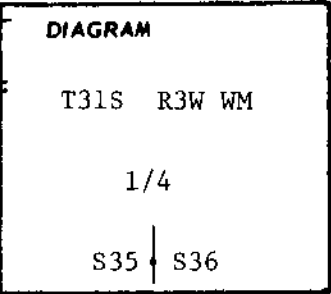

A fir, 6" diam, bears N 21° E, 22 lks. dist, mkd 1/4 S BT.

A fir, 18" diam, bears N 81° W, 31 lks. dist, mkd 1/4 S BT.

The corner was renewed in 1966 by John M. Powell, Douglas County Surveyors Office, who set a 1" iron pipe with brass cap marked: COUNTY SURVEYORS OFFICE T31S R3W 1/4 S35 S36 1966, and marked a new bearing tree:

A 20" Douglas fir, bears N 7° W, 75.2 ft, scribed 1/4 S35 CS BT. and reblazed and rescribed:

A 34" Douglas fir, bears S 81° W, 20.4 ft, scribed 1/4 S35 CS BT.

Description of corner evidence found:

1" iron pipe, firmly set, 15" above the ground, with a 2 1/2" brass cap marked: "COUNTY SURVEYORS OFFICE T31S R3W 1/4 S35 S36 1966" from which an original bearing tree:

A 34" Douglas fir snag, with scribe marks "1/4 S35 CS BT" visible, bears S 81° W, 20.4 ft. and a bearing tree marked by Powell:

A 24" Douglas fir, with scribe marks "1/4 S35 CS BT" visible, bears N 7° W, 75.2 ft.

Description of monument and accessories established to perpetuate the original location of this corner

Marked new bearing tree:

A 6" Douglas fir, bears S 38° E, 32.5 ft, marked "1/4 S36 BT" on a double blaze and nailed a brass washer stamped "LS 536" into lower blaze

Compass Declination: 20° East

FILED
RECEIVED

DEC 4 1979

COUNTY SURVEYOR
DOUGLAS COUNTY, ORE.

REGISTERED
PROFESSIONAL
LAND SURVEYOR

OREGON
JULY 14, 1961
GLENN S. BAUGHMAN
536

Office of Surveyor County of Douglas

State of Oregon, I hereby certify that the within instrument was filed in this office

for record on the 4th day of December, 1979, at 4:15 o'clock p.m. (signed)

Francis L. Ingram by Virginia A. Langen
(COUNTY OFFICIAL) (DEPUTY)

#211 X