

CERTIFIED RECORD OF LAND CORNER MONUMENTATION

History of original corner establishment: The corner was originally established in 1871 under Contract No. 152, by William H. Byars, who set a post from which:

- A fir, 30" diam, bears N 5° E, 40 lks dist.
- A laurel, 6" diam, bears S 80° E, 25 lks dist.
- A fir, 12" diam, bears S 30° W, 41 lks dist.
- A laurel, 8" diam, bears N 80° W, 38 lks dist.

The corner was renewed in 1913 by Fred Mensch, Deputy Surveyor, who set a 15x15x12" granite stone, marked with 4 notches on South and 3 notches on East edge; from which;

- A fir, 30" diam, bears N 2° E, 40 lks dist, mkd T32S R3W S10 BT.
- A fir, 20" diam, bears S 1° E, 57 lks dist, mkd T32S R3W S15 BT.
- A fir, 18" diam, bears S 34° W, 42 lks dist, mkd T32S R3W S16 BT.
- A fir, 18" diam, bears N 43° W, 59 lks dist, mkd T32S R3W S9 BT.

The corner was renewed in 1945 by Ben B. Irving, County Surveyor, who marked new bearing trees:

- A 5" sugar pine, bears S 75° E, 6 lks dist.

~~Description of corner and blaze from:~~

- A 6" madrona, bears N 77° W, 29 lks dist.

The corner was renewed in 1969 by Glenn S. Baughman, who set a 1" iron pipe with Brass Cap marked: "T32S R3W WM 9 10 15 16 1969 536" and marked a new bearing tree:

- A 10" laurel, bears N 57°30' E, 18.9 ft.

The corner was renewed in 1969 by John M. Powell, Douglas County Surveyors Office, who marked a new bearing tree:

- A 6" Douglas fir, bears N 54° W, 17.9 ft, mkd T32S R3W S9 CS BT.

DESCRIPTION OF CORNER EVIDENCE FOUND: 1" iron pipe, firmly set, projecting 12" above ground with a 2 1/2" Brass Cap marked: "T32S R3W WM 9 10 15 16 1969 536" from which original bearing trees:

- A 32" Douglas fir stump, scribe marks "BT" visible, bears N 2° E, 26.4 ft.
- A 20" Douglas fir stump, scribe marks "R3W S9 BT" visible, bears N 43° W, 38.9 ft to face.
- A 24" Douglas fir, with healed blaze, bears S 1° E, 37.6 ft.

and bearing trees marked by Irving:

- A 16" sugar pine, with healed blaze, bears S 75° E, 4.0 ft.

~~Description of monument and accessories established to perpetuate the~~

~~original location of this corner:~~

A 10" madrona, with healed blaze, bears N 77° W, 18.1 ft. (record 19.1 ft) and bearing tree marked by Baughman:

- A 10" laurel, scribe marks "T32S R3W S10 BT" visible, bears N 57 1/2° E, 18.9 ft.


and bearing trees marked by Powell:

- A 10" Douglas fir, with healed blaze, bears N 54° W, 17.9 ft.

DESCRIPTION OF MONUMENT AND ACCESSORIES I ESTABLISHED TO PERPETUATE THE ORIGINAL LOCATION OF THIS CORNER.

Marked new bearing tree:

- A 24" Douglas fir, bears S 41° W, 47.9 ft., marked "T32S R3W S16 BT" on a double blaze and nailed a brass washer stamped "LS 536" into lower blaze.

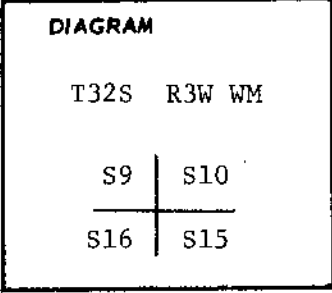

FILED
RECEIVED

Compass Declination: 20° East.

DEC 4 1979

**REGISTERED
PROFESSIONAL
LAND SURVEYOR**

OREGON
JULY 14 1961
GLENN S. BAUGHMAN
536

Glenn S. Baughman

COUNTY SURVEYOR

DOUGLAS COUNTY, ORE. Office of _____ Surveyor _____ County of Douglas _____

State of Oregon, I hereby certify that the within instrument was filed in this office

for record on the 4th day of December, 1979, at 4:10 o'clock p.m. (signed)

Francis L. Ingram by *Francis L. Ingram*
(COUNTY OFFICIAL) (DEPUTY)