


CERTIFIED RECORD OF LAND CORNER MONUMENTATION

History of original corner establishment: The corner was originally set in 1871 under Contract No. 152, by William H. Byars who set a post for the corner to Sections 15, 16, 21, and 22 from which:

- A fir, 10" diam, bears N 45° E, 14 lks. dist.
- A fir, 5" diam, bears S 50° E, 19 lks. dist.
- A fir, 10" diam, bears S 40° W, 10 lks. dist.
- A fir, 12" diam, bears N 60° W, 20 lks. dist.

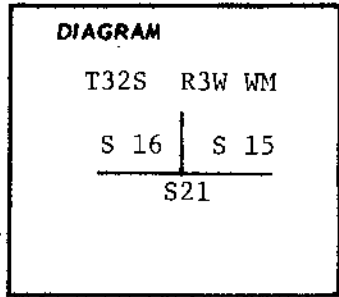

The corner was renewed in 1913 by Fred Mensch, Deputy Surveyor, under Contract No. 757, who re-established it as the corner to Sections 15, and 16 only, and set a granite stone, 18 x 12 x 5", marked with 3 notches on the East edge from which:

- A fir, 16" diam, bears N 50° E, 14 lks. dist, mkd T32S R3W S15 BT.
- A fir, 18" diam, bears N 64° W, 20 lks. dist, mkd T32S R3W S16 BT.

The corner was renewed in 1969 by John M. Powell, Douglas County Surveyors Office, who set a 1" iron pipe with Brass Cap marked: "COUNTY SURVEYORS OFFICE T32S R3W S15 S16 S21 1969", and marked a new bearing tree:

- A 20" Douglas Fir, bears S 37° W, 9.2 ft, mkd T32S R3W S21 CS BT.

Description of corner evidence found:

1" iron pipe, firmly set, projecting 12" above the ground with a 2 1/2" Brass Cap marked: "COUNTY SURVEYORS OFFICE T32S R3W S15 S16 S21 1969" from which original bearing trees:

- A 20" Douglas Fir, with healed blaze, bears N 64° W, 13.2 ft to face.
- A 18" Douglas Fir, high cut stump, with healed blaze, bears N 50° E, 9.2 ft.

and bearing trees marked by Powell:

- A 20" Douglas Fir, with healed blaze, bears S 37° W, 9.2 ft.

Description of monument and accessories established to perpetuate the original location of this corner

Marked new bearing tree:

A 14" Douglas Fir, bears N 2 1/2° E, 97.7 ft, marked "T32S R3W S15 BT" on a double blaze and nailed a brass washer stamped "LS 536" into lower face.

Compass Declination: 20° East.

**REGISTERED
PROFESSIONAL
LAND SURVEYOR**

OREGON
JULY 14, 1961
GLENN S. BAUGHMAN
536

FILED
RECEIVED

1979

**COUNTY SURVEYOR
DOUGLAS COUNTY, ORE**

Office of.....Surveyor..... County of.....Douglas.....
State of.....Oregon....., I hereby certify that the within instrument was filed in this office
for record on the ..4th day of ..December....., 19..79, at 4:10 o'clock ..p.m., (signed)
.....Frances L. "Fritz" Ingram..... by *Virginia C. Langford*
(COUNTY OFFICIAL) (DEPUTY)