


CERTIFIED RECORD OF LAND CORNER MONUMENTATION

History of original corner establishment:

June 1908 Mensch
36" Fir for Closing Corner
20" Madrone S1⁰W 29 Lks. "T31S,R2W,S4 BT"
12" Fir S33⁰E 52 Lks "T31S,R2W,S4 BT"

August, 1966 County Surveyor
Set Brass cap on South side of tree, marked as shown
Rescribed 25" Laurel S1⁰W 19.1 ft.

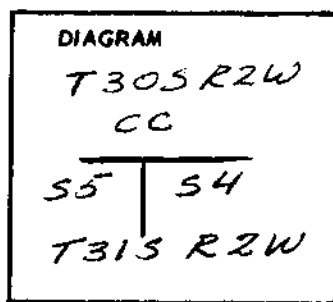


FILED
RECEIVED *JL*

FEB 22 1978

COUNTY SURVEYOR
DOUGLAS COUNTY, ORE.

Description of corner evidence found:

Found 42" D. Fir Corner Tree
A 1" Iron Pipe & 2 1/2" Brass Cap attached is next to
south side of tree.
Brass cap marked as shown above.
24" Madrone S5 1/2⁰W 18.4 feet scribe visible

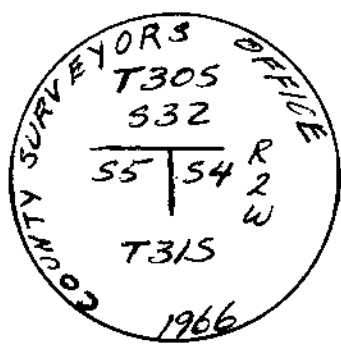

Description of monument and accessories established to perpetuate the original location of this corner

No suitable bearing trees in Southeast quadrant.
Set 6 foot steel fence post approximately 2 feet into
the ground and attached bearing tree sign. Painted
top of post red. Post bears S70 3/4⁰E 17.8 feet
from corner tree.

[Handwritten Signature]

Bearing based on solar observation
Magnetic decl. approx. 21⁰ East.

Office of County Surveyor County of Douglas
State of Oregon, I hereby certify that the within instrument was filed in this office
for record on the 22 day of February, 1978, at 4 o'clock P.m., (signed)
FRANCIS L. INGRAM by Gregory E. Stribell
(COUNTY OFFICIAL) (DEPUTY)

#218-730-2 X
#198-731-2 X