

RENEWAL OF $\frac{1}{4}$ CORNER ON WEST SIDE OF:

SECTION 30 T26S R1E W.M.


FOUND BOTH BEARING TREES WITH GOOD HEALED OVER SCARS AND FOREST SERVICE B.T. TAGS.

BOTH TREES IN EXCELLANT CONDITION AND BOTH ARE NOW APPROXIMATELY 32" IN DIAMETER.

THE AREA HAS BEEN LOGGED OVER IN A SELECTIVE-CUT HI-LEAD LOGGING SHOW. THE BRASS CAP AND PIPE WERE PULLED AND LOST DURING THE LOGGING.

FOUND THE ORIGINAL HOLE WHERE THE CORNER PIPE HAD BEEN, AND WAS ABLE TO IDENTIFY BY THE CALLS FROM THE TWO BEARING TREES.

SET A $\frac{5}{8}$ " X 30" IRON ROD, IN THE ORIGINAL HOLE, WITH AN ALUMINUM CAP MARKED:

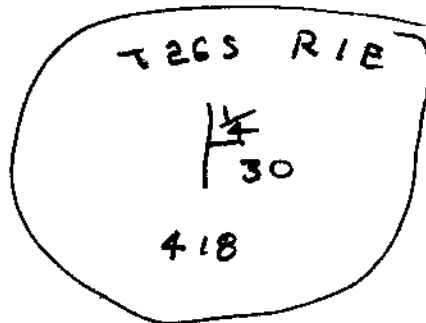

REGISTERED PROFESSIONAL LAND SURVEYOR

Burton W. Holt

OREGON
OCTOBER 4, 1987
BURTON W. HOLT
418

DID NOT MARK ANY NEW TREES.

MAR 28, 1980

#13 T26-1E X
#98 T26-1W X

C.S. FILE
Vol 22
Pg. 3523

FILED ✓
RECEIVED ✓
APR 1 1980
COUNTY SURVEYOR
DOUGLAS COUNTY, ORE.