

**CERTIFIED RECORD OF LAND CORNER MONUMENTATION**

History of original corner establishment: Dennis Hathorn surveyed in 1857, Contract # 73.

Set post for corner

Marked:

12" Pine S. 80° W. 16 links

6" Pine S. 55° E. 43 links

Renewed by John Powell 1968.

Set 1" iron pipe with brass cap attached.

Marked:

11" White Fir S. 89° E. 46.1 feet


8" White Fir S. 61° E. 32.6 feet

**Description of corner evidence found:**

Found 1" iron pipe with brass cap


14" White Fir S. 89° E. 46.1 feet

10" White Fir S. 61° E. 32.6 feet

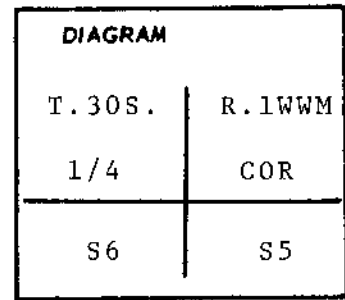

County Surveyors Office

T. 30S. R. 1W

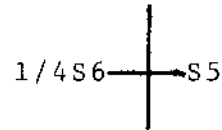

**Description of monument and accessories I established to perpetuate the original location of this corner**

I marked a 6" Douglas Fir S. 32° W. 21.9 feet "1/4 S6 BT" on a double blaze and attached a brass washer stamped Land Surveyor 536 on lower face.

FILED  
RECEIVED

MAY 25 1979

COUNTY SURVEYOR  
DOUGLAS COUNTY, ORE.

REGISTERED  
PROFESSIONAL  
LAND SURVEYOR

*Glenn S. Baughman*

OREGON  
JULY 14, 1961  
GLENN S. BAUGHMAN  
536

Office of County Surveyor County of Douglas  
Oregon  
State of Oregon, I hereby certify that the within instrument was filed in this office  
for record on the 22 day of May, 1979, at 9 o'clock a.m. (signed)  
Francis L. Ingram by Theresa A. Ferguson  
(COUNTY OFFICIAL) (DEPUTY)

*Deposited  
# 194*