

CERTIFIED RECORD OF LAND CORNER MONUMENTATION

History of original corner establishment: Dennis Hathorn surveyed in 1857, Contract # 73.  
Set post for corner.


Marked:  
12" Pine S. 80° W. 16 links  
6" Pine S. 55° E. 43 links

Renewed by John Powell 1968. #31  
Set 1" iron pipe with brass cap attached.

Marked:  
11" White Fir S. 89° E. 46.1 feet  
8" White Fir S. 61° E. 32.6 feet

**Description of corner evidence found:**

Found 1" iron pipe with brass cap.  
14" White Fir S. 89° E. 46.1 feet  
10" White Fir S. 61° E. 32.6 feet

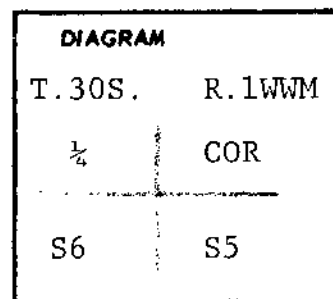

FILED  
RECEIVED

APR 23 1979

COUNTY SURVEYOR  
DOUGLAS COUNTY, ORE.

County Surveyors  
Office  
T. 30S. R. 1W  
1/4 S6 + S5

**Description of monument and accessories I established to perpetuate the original location of this corner**

I marked a 6" Douglas Fir S. 32° W. 21.9 feet "1/4 S6 B T"  
and attached a brass washer stamped Land Surveyor 536  
on lower face.

REGISTERED  
PROFESSIONAL  
LAND SURVEYOR

*Alvin A. Baughman*

CLERK

Office of Surveyor County of Douglas  
State of Oregon, I hereby certify that the within instrument was filed in this office  
for record on the 23 day of April, 1979, at 1 o'clock 35 m., (signed)  
..... by Dubois W. Leady  
(COUNTY OFFICIAL) (DEPUTY)

#194 →