


CERTIFIED RECORD OF LAND CORNER MONUMENTATION

History of original corner establishment: I surveyed and set
2" iron pipe with brass cap.
June 1967

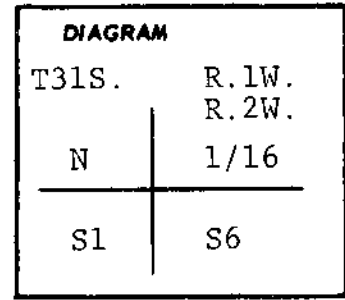

MKD:
16" Douglas Fir S. 22° W. 12.0 feet.
36" Sugar Pine N. 1° 30' W. 46.5 feet.

FILED
RECEIVED


APR 23 1979

Description of corner evidence found:

COUNTY SURVEYOR
DOUGLAS COUNTY, ORE

Found 2" iron pipe with brass cap
18" Douglas Fir S. 22° W. 12.0 feet
36" Pine stump N. 1½° W. 46.5 feet

Description of monument and accessories I established to perpetuate the
original location of this corner I marked 8" Douglas Fir N. 9° W. 19.2 feet
"N. 1/16 S - 1" bearing tree and fastened brass washer stamped Land
Surveyor 536 in lower part of blaze.

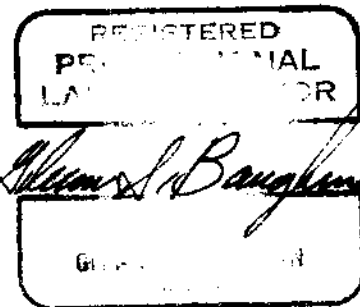

Office of Surveyor County of Douglas
State of Oregon, I hereby certify that the within instrument was filed in this office
for record on the 23 day of April, 1979, at 1 o'clock 35 m., (signed)
..... by Deloris W. Sealey
(COUNTY OFFICIAL) (DEPUTY)

#175 T31-1 X
#201 T31-2 X