


**CERTIFIED RECORD OF LAND CORNER MONUMENTATION**

History of original corner establishment: 1917 retracement survey by Elmer Strickler. Renewed by John Powell 1968. Set stone for corner (original). Replaced with brass cap on 1" iron pipe.

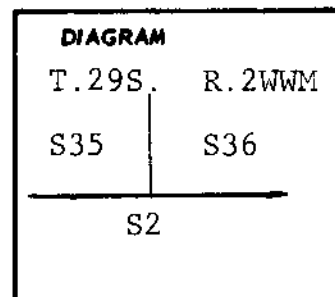

Original trees marked:

- 30" Fir N. 45° 30' E 19 links
- 15" Fir N. 47° W. 58 links

Renewed trees:

- 24" Douglas Fir N. 38.0 feet
- 20" Douglas Fir N. 10° W. 25.7 feet
- 8" White Fir S. 24° W. 18.6 feet

Description of corner evidence found:

- Found 1" iron pipe with brass cap. # 31 1979
- 10" White Fir S. 24° W. 18.6 feet 131 1979
- 20" Douglas Fir N. 10° W. 25.7 feet
- 24" Douglas Fir (Snag) N. 38.0 feet
- 30" Douglas Fir (Down) N. 45½° E. 12.5 feet

**FILED  
RECEIVED**

**APR 23 1979**

**COUNTY SURVEYOR  
DOUGLAS COUNTY, ORE.**

County Surveyor  
Office  
T.29S. R. 2 W.  
S35 S36  
-----  
T.30S. R.2 W.  
1968

Description of monument and accessories I established to perpetuate the original location of this corner

I marked 6" White Fir N. 24° E. 31.1 feet " S 36 B T " and attached brass washer stamped Land Surveyor 536 on lower face.



Office of SURVEYOR County of DOUGLAS  
State of OREGON, I hereby certify that the within instrument was filed in this office for record on the 23 day of April, 1979, at 1 o'clock PM, (signed)  
by Glenn E. Berman  
(COUNTY OFFICIAL) (DEPUTY)

# 219 T30-2  
# 111 T29-2