


T21S

FILED
RECEIVED *vh*

OCT 16 1979

COUNTY SURVEYOR
DOUGLAS COUNTY, ORE.

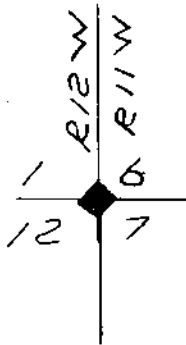

SECTION COR.

SET 2" I.P. / BR. CAP FROM WH:


- 10" FIR BRS. N 54° E, 15.8'
 - 12" FIR BRS. S 31° E, 9.7'
 - 10" HEM. BRS. S 39° W, 38.8'
 - 12" FIR. BRS. N 43° 30' W, 9.8'
- } SCRIBED

#127 T21-11 X
#60 T21-12 X

CORNER FALLS IN CAT ROAD

T21S

1/4 COR.

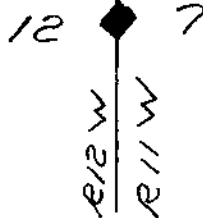

SET 2" I.P. / BR. CAP FROM WH:

- 14" HEMLOCK BRS. N 46° E, 17.9'
 - 18" SPRUCE BRS. S 48° 30' W, 11.0'
- } SCRIBED

SURVEY IN PROGRESS IN SECTIONS

1, 11, 12 & 13 OF T21S, R12W

#128 T21-11 X
#61 T21-12 X

Q. S. File No. 58/176-32 10-13-79 *RJA.* C