


**CERTIFIED RECORD OF LAND CORNER MONUMENTATION**

**History of original corner establishment:** Corner was originally set by Dennis Hathorn in 1857 under Contract No. 73. The corner was reset in a new position by Fred Mensch, U.S. Cadastral Engineer, under a 1923 Dependent Resurvey. Mensch set a 1" x 36" iron post, 28" in the ground with brass cap marked "1/4 S9 1923" from which:

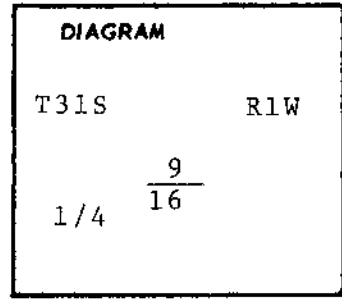

a 10" Yew bears S81°W, 36 lks.

a 8" Fir bears N18°W, 23 lks.

In 1968, the corner was renewed by John Powell, Do. Co. Surveyors Office, who marked bearing trees:

a 42" D. Fir bears N65°E, 44.0 ft.

a 7" Hemlock bears S5°W, 95.0 ft.

**Description of corner evidence found:**

1" iron pipe with a 2-1/2" Brass Cap set 8" above the ground and marked: 1/4 S9 1923 from which:  
S16

a 10" Yew, down and burnt, bears S81°W, 23.8 ft.

a 13" D. Fir snag bears N18°W, 15.2 ft.

a 42" D. Fir stump bears N65°E, 44.0 ft.

a 10" Hemlock bears S5°W, 95.0 ft.


**Description of monument and accessories I established to perpetuate the original location of this corner**

**New bearing tree:**

14" D. Fir bears N32-1/2°W, 114.6 feet, I marked "1/4 S9 BT" on a double blaze and nailed a brass washer stamped "LS 536" into lower blaze.



*Glenn S. Baughman*

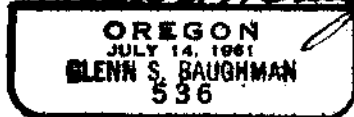

Office of SURVEYOR County of DOUGLAS  
State of OREGON, I hereby certify that the within instrument was filed in this office for record on the 18 day of JULY, 1979, at 2 o'clock 30 m., (signed)  
Frances St. Myron by Nelson W. Keady  
(COUNTY OFFICIAL) (DEPUTY)

#178 X