



CERTIFIED RECORD OF LAND CORNER MONUMENTATION

History of original corner establishment: Corner was originally established in 1883, by Rufus Moore under General Land Office, Contract No. 475. Moore set a 4"x4" post, 4 ft. long, from which: a 33" fir, bears N58°E, 29 lks.; a 3" fir, bears S74°E, 23 lks.; a 4" fir, bears S65°W, 7 lks.; a 14" fir, bears N58°W, 7 lks. The corner was renewed by the Douglas County Surveyors Office in 1963, who set a Brass Cap marked: "COUNTY SURVEYORS OFFICE T32S R2W S12 S7 S13 S18 1963", from which: a 6" Chinguapin, bears N38°W, 48.7 ft.; a 20" W. fir, bears N22°E, 49.6 ft.; a 36" fir, bears S50°E, 29.0 ft.; a 6" W. fir, bears S86°E, 68.3 ft.;

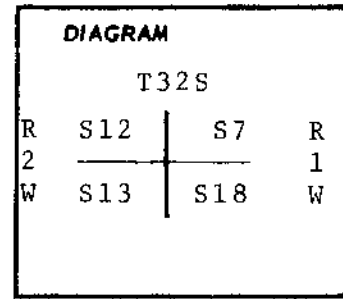

The corner was renewed in 1976, by Glenn S. Baughman, who marked new BT's: a 10" D. fir, bears N85°W, 23.3 ft.; a 9" D. fir, bears S34°E, 21.6 ft.; a 10" W. fir, bears N15°W, 62.3 ft..

Description of corner evidence found: A 1" iron pipe projecting 24" above the ground with a 2-1/2" Brass Cap marked: "COUNTY SURVEYORS OFFICE" from which: a 35" D. fir rotted stump, bears N58°E, 19.1 ft.; a 6" Chinguapin snag with scribe marks "S12CSBT" visible, bears N38°W, 48.7 ft.; a 20" W. fir with healed blaze, bears N22°E, 49.6 ft.; a 36" fir, wind thrown snag, bears S50°E, 29.0 ft.; a 12" D. fir with scribe marks "T32S R2W S13 BT" visible on a partially healed blaze, bears N85°W, 23.3 ft.; a 10" D. fir with scribe marks "T32S R1W S18 BT" visible on a partially healed blaze, bears S34°E, 21.6 ft.; a 10" W. fir with scribe marks "T32S R2W S12 BT" visible on a partially healed blaze, bears N15°W, 62.3 ft.

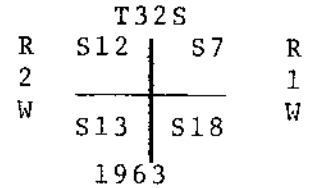

Description of monument and accessories | established to perpetuate the original location of this corner

a 10" D. fir, bears S72°W, 40.3 ft., I marked "T32S R2W S13 BT" on a double blaze and nailed a brass washer stamped "LS 536" into lower blaze.

a 12" D. fir, bears N85°W, 23.3 ft., marked by Baughman in 1976, I chopped out "S13" and remarked "S12".

**REGISTERED
PROFESSIONAL
LAND SURVEYOR**

Glenn S. Baughman

OREGON
JULY 14, 1961
GLENN S. BAUGHMAN
836

Office of SURVEYOR County of DOUGLAS
State of OREGON, I hereby certify that the within instrument was filed in this office
for record on the 18 day of JULY, 1979, at 2 o'clock 30 m., (signed)
Glenn S. Baughman by Richard W. Keady
(COUNTY OFFICIAL) (DEPUTY)

#17 T32-1 X
#109 T32-2 X