

SURVEY FOR PROPERTY CORNERS

FOR GEORGE JEFFERSON
BY BAUGHMAN TECHNICAL

SCALE 1"=100' MARCH 1979

LOT 9, PEARL SUB., SEC. 14, T.28 S., R.6 W.W.M.

- Set 1/2" I.R.
- Fd. 1/2" I.R.
- ♂ Fd. 5/8" I.R.
- ⊙ Fd. 3/4" I.R.

REGISTERED
PROFESSIONAL
LAND SURVEYOR

Glenn S. Baughman


OREGON
JULY 14, 1961
GLENN S. BAUGHMAN
536

FILED ✓
RECEIVED ✓

MAR 23 1979

COUNTY SURVEYOR
DOUGLAS COUNTY, ORE.

COUNTY SURVEYORS FILE DATA
DO NOT REMOVE FROM OFFICE

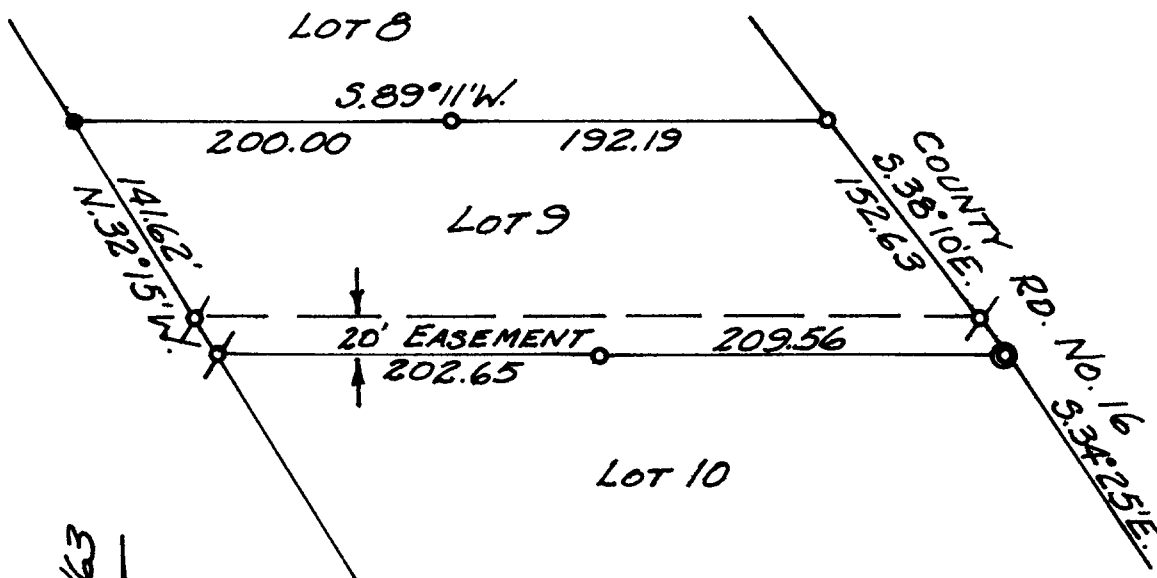

BASED ON C.S. 55/63