


TOWNSHIP 30 SOUTH
RANGE 4 EAST

FIRST RE-ESTABLISHMENT

Quarter corner common to Sec. 36, Twp. 29 South, Range 4 East and Sec. 1, Twp. 30 South, Range 4 East, W.M. V=18°

Fd, the original 1 x 36 ins. (2.5 x 91 cm) iron pipe with standard G.I.O. brass cap mkd:

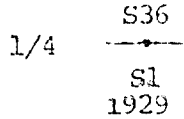

lying horizontal, 6 ins. (15 cm) below the surface of the ground.

I straightened and re-set the above, 26 ins. (66 cm) in the ground in its original position.

Original bearing trees recorded by H. Raymond in 1929 fd as follows:

white fir, 14 ins. (36 cm) diam., with healed single blaze, brs record; S8W, 27.06 ft. (8.25 cm) to center.

shasta red fir, 38 ins. (97 cm) diam. with healed single blaze, brs record; N23W, 32.34 ft. (9.86 m) to center.

Corner lies in cat logged area, about 300 ft. (91 m) East of location marker on 12 ins. (30 cm) diam. fir, alongside road.

August 3, 1978

B. Malotte

R. Frost


Approved by: Ed McGinty
Co. Surveyor

8 T30-4E ✓
1 T29-4E ✓

FIRST RE-ESTABLISHMENT

Section corner common to Secs. 33 and 34, Twp. 29 South, Range 4 East and Secs. 3 and 4, Twp. 30 South, Range 4 East, W.M. V=17°

From the following evidence, at the location described below, I set a 1 x 36 ins. (2.5 x 91 cm) G.I. pipe, with a 2-1/2 ins. (6 cm) bronze disc mkd:

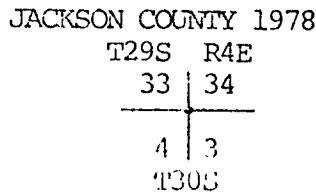

from which, original bearing trees recorded by H. Raymond in 1929 fd as follows:

fir snag, 14 ins. (36 cm) diam., with healed single blaze, brs record; N34E, 9.90 ft. (3.02 m) to center.

SE BT now gone.

shasta red fir, 24 ins. (61 cm) diam., containing scribe mkd in partially exposed single face, brs S56W, 16.11 ft. (4.91 m) to center. Record; S56W, 16.50 ft. (5.03 m).

douglas fir, 23 ins. (58 cm) diam. with healed single blaze, brs N19-1/2W, 17.77 ft. (5.42 m) to center. Record; N19-1/2W, 17.16 ft. (5.23 m).

Original monument not fd.

I mound stones around corner and mk a new tree CS-BT:

hemlock, 6 ins. (15 cm) diam., brs S21W, 25.43 ft. (7.75 m) to center of tree at lower blaze.

NOTE: No trees available in NE Quadrant.

Corner lies about 40 ft. (12 m) South of road, C E-W.

August 7, 1978

J. Swanson

R. Frost

Approved by: Ed McGinty
Co. Surveyor

9 T30-4E ✓
2 T29-4E ✓

FILED
RECEIVED 2/1

NOV 20 1978

COUNTY SURVEYOR
DOUGLAS COUNTY, ORE.

C. S. File No. 53/183-7