

CERTIFIED RECORD OF LAND CORNER MONUMENTATION

History of original corner establishment:


Corner established in 1910 by Mensch under G.L.O. contract.

Mensch chisled a + and 1/4 in bedrock on the East side of the S. Umpqua River and scribed the following trees;

16" Oak (now dead) S54 1/2° E 157 lks. (still exists and shows good scars)

16" Fir (now 24") N1° W 117 lks. (Good tree)

In 1969 the Douglas County Surveyor scribed a new B.T.;
11" D.F. (now 14") S69° E 118.5' (Good tree)

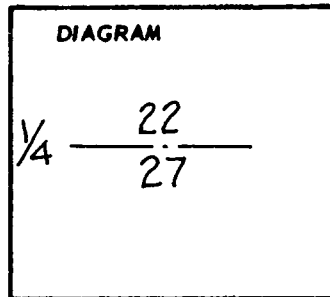

Description of corner evidence found:

I found all of the historic data listed above.

FILED ✓
RECEIVED ✓

JAN 9 1979

COUNTY SURVEYOR
DOUGLAS COUNTY, ORE.

✓

Description of monument and accessories established to perpetuate the original location of this corner

At the position of the + chisled in bed rock I star drilled a hole into the rock and firmly grouted a 3" Brass disk (with a 4" twisted and fluted stem) into place. In the grouting process it was necessary to completely cover up the chisled 1/4 sign.

I set a steal fence post above bedrock and high water easterly about 30 feet with signs 54-4 and 54-9 attached by wire.


The Brass disk is stamped as shown.

I hereby certify the above corner monument was re-established as herein described on December 8, 1978.

REGISTERED
PROFESSIONAL
LAND SURVEYOR

Wayne Rogers

OREGON
NOV 16 1973
WAYNE ROGERS
1004

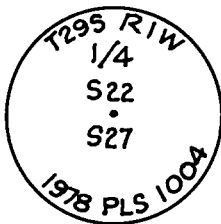

Witnesses

G.V. Nygren
G.V. Nygren

K. Curphey
K. Curphey

Office of Surveyor County of Douglas

State of Oregon, I hereby certify that the within instrument was filed in this office

for record on the 23 day of January 1979, at 10 o'clock a.m., (signed)

Francis L. Ingram by *Virginia A. Langer*
(COUNTY OFFICIAL) (DEPUTY)

#128 ✓