

ROSEBURG LUMBER CO.

P.O. BOX 1088 • ROSEBURG, OREGON 97470 PHONE (503) 679-8741

February 7, 1979

FILED
RECEIVED

FEB 9 1979

COUNTY SURVEYOR
DOUGLAS COUNTY, ORE.


Mr. Fritz Ingram
Douglas County Surveyor
Douglas County Courthouse
Roseburg, OR 97470

Dear Fritz:

I have renewed the bearing trees for the NE corner of Tract 37,
Section 33, T. 24S., R. 2W., W.M.

Found:

Iron pipe with brass cap marked:

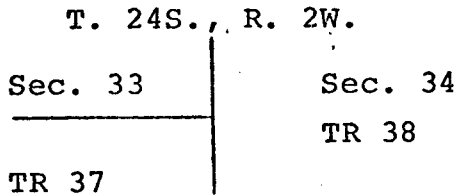

11" Cedar S66½W 19.8 Ft. broken off above visible scribe.
11" Hemlock N19W 4.6 Ft. down.

Scriped the following new bearing trees.

12" Cedar N72W 27.0 Ft. "TR37 S33 BT"
8" Hemlock S18W 36.2 Ft. "TR37 S33 BT"

Sincerely,

ROSEBURG LUMBER CO.

Howard W. Johnstone

Howard W. Johnstone
Logging Engineer

REGISTERED
PROFESSIONAL
LAND SURVEYOR

Howard W. Johnstone

OREGON
MAY 13, 1960
HOWARD W. JOHNSTONE
498

99 X c