

COUNTY SURVEYORS FILE DATA  
DO NOT REMOVE FROM OFFICE

N.W. COR. WARREN FOSTER D.L.C. 45

N. LINE WARREN FOSTER D.L.C.

COUNTY ROAD 40' WD.

S. 88° 45' E. 708.0'

GREEN ST.

TOWNSITE

INITIAL POINT  
1/2" PIPE

Fence Post  
Fence Corner  
1/2" Angle Iron

40' 40' 40' 40'

8 9 10 11  
12 13 14

DOUGLAS NAT. BANK

15' Army

DOUGLAS NAT. BANK

ch. s. fence

60' MYRTLE ST.

3/8" Spring Leaf  
Eye end up

S. 88° 45' E. 340.0'

SECOND AVE.

S. 17° 03' W. 328'

S. 17° 03' W. 260'

1/2" Iron Pipe

1/2" Pipe

S. 88° 45' E. 1670'

1/2" Strap Iron


S. 17° 03' W. 175'

S. 72° 37' E. 2200'

1/2" Angle Iron  
set 3"  
from  
Corner

FILE 2  
RECEIVED  
MAR 22 1979  
COUNTY SURVEYOR  
DOUGLAS COUNTY, ORE.

PEAR ORCHARD

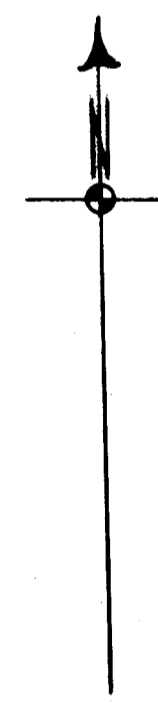

W. LINE WARREN FOSTER D.L.C.

N. 07° 05' E. 1635.3'

R. L. PRESTON  
DOUGLAS NAT. BANK

N. 88° 09' W. 276.6'

N. 82° 22' W. 257.5'

N. 84° 43' W. 719.2'

S. 17° 03' W. 1345'

WEST RIV LINE  
SOUTHERN PACIFIC MAIN LINE &

COUNTY SURVEYORS FILE DATA  
DO NOT REMOVE FROM OFFICE

COUNTY SURVEYORS OFFICE, ROSEBURG, ORE.  
DOUGLAS NAT. BANK PROPERTY AT GREEN  
IN WARREN R. FOSTER DON. LND. CLAIM IN SEC. 11  
T. 26S, R. 6W, WIL. MERIDIAN, DOUGLAS COUNTY, ORE.  
SEPT 1942 ABayer, Dep. Scale, 1" = 100ft.

DRAWN 54

C. S. File No. C.S. 58/194-10