


REVISION OF LOTS 18 AND 19, RUST SUBDIVISION
 SECTION 19, T. 27 S., R. 5 W., W. M.
 SURVEYED FOR ROBERT BURZYNSKI
 SURVEYED BY R. H. GEE JULY, 1979
 SCALE 1" = 50'

FILED
[Signature]

JUL 2 1979

COUNTY SURVEYOR
 CLATSOP COUNTY, ORE.

COUNTY SURVEYORS FILE DATA
 DO NOT REMOVE FROM OFFICE

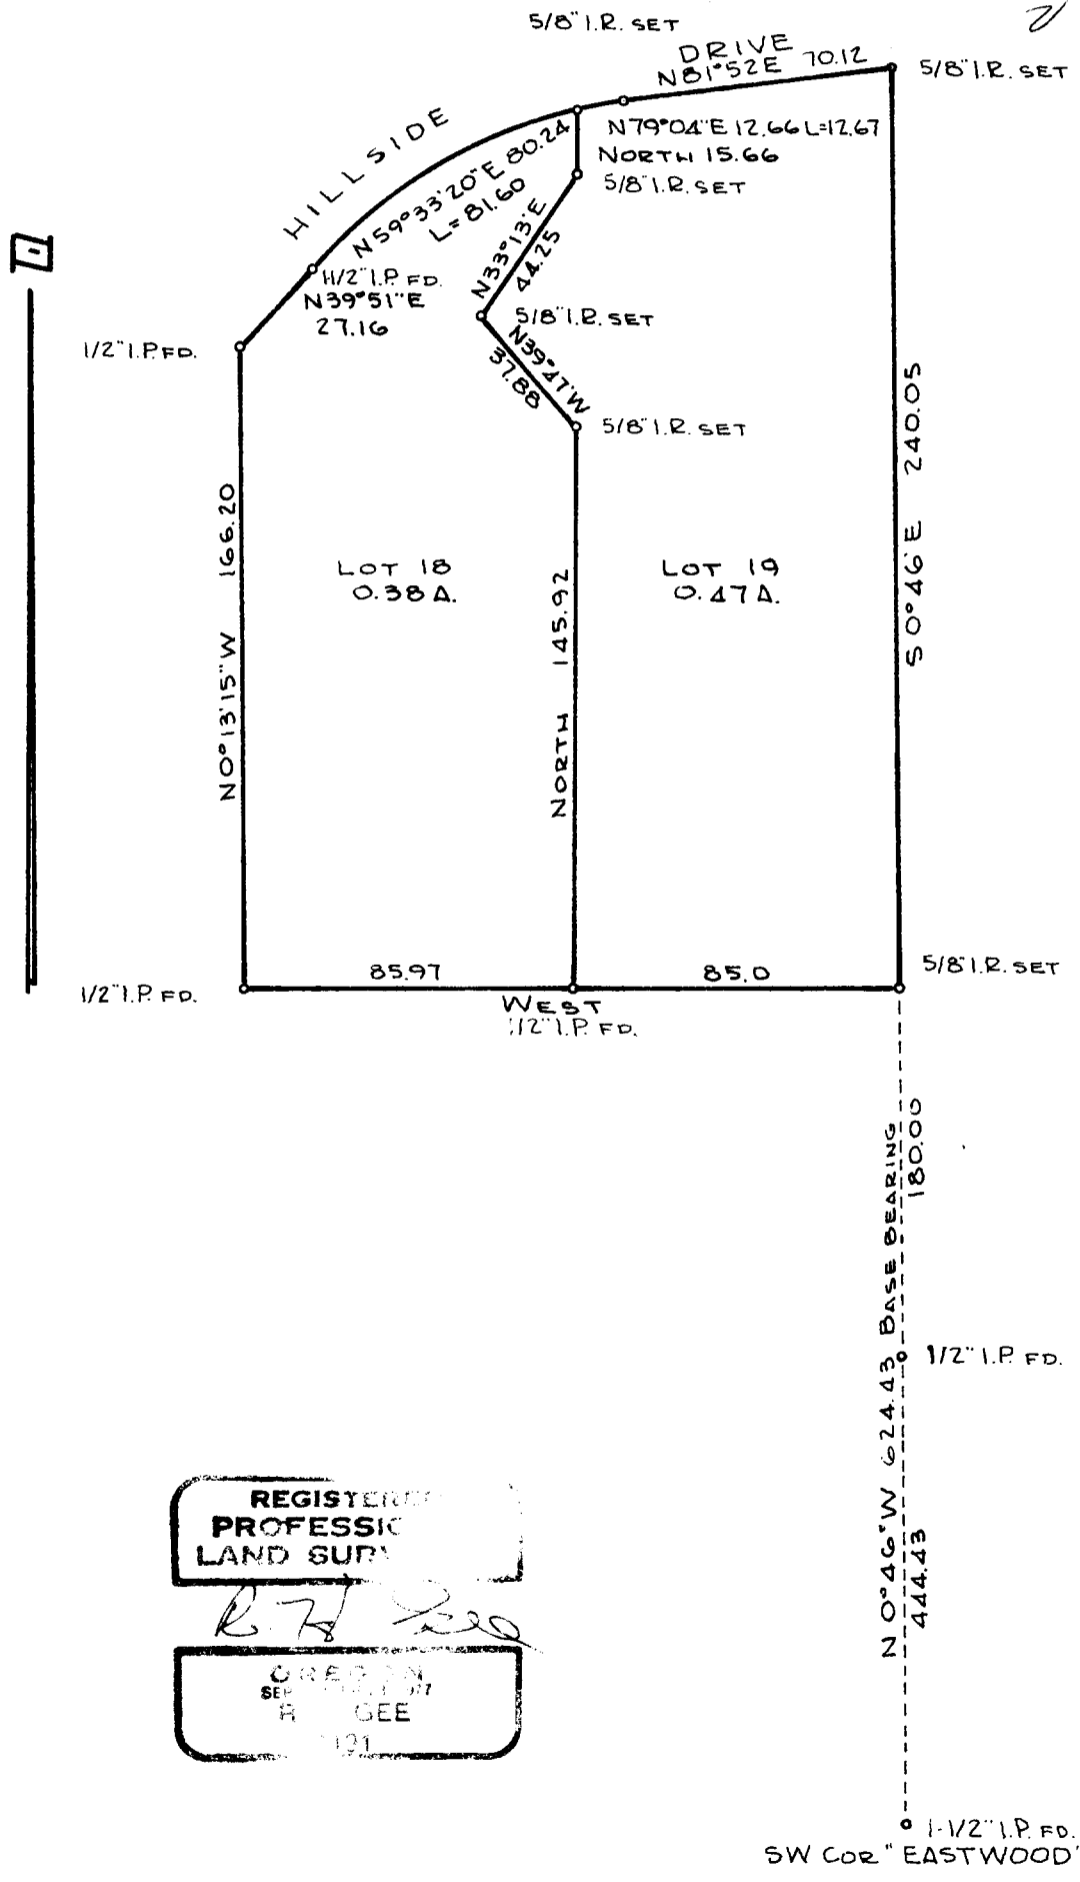

REGISTERED
 PROFESSIONAL
 LAND SURVEYOR
[Signature]
 OREGON
 SEP 1977
 R. H. GEE
 191