

PRELIMINARY ADMINISTRATIVE SURVEY
 FOR FOREST MANAGEMENT PURPOSES OF THE
 MEDFORD DISTRICT
 BUREAU OF LAND MANAGEMENT

DOUGLAS COUNTY SURVEYORS FILE DATA
DO NOT REMOVE FROM OFFICE

FILED *v*
 RECEIVED *JK*

JUL 17 1979

COUNTY SURVEYOR
 DOUGLAS COUNTY, ORE.

JB

T. 33 S., R. 4 W., SEC. 5, W. M.
 DOUGLAS COUNTY

SURVEYED BY: D. Cummins DATE: June 1979

REFERENCES

Ref. No. 1
 U.S. Gov't. remonumentation, Gp. 350.
 J. Jelley, U.S. Cadastral Surveyor.
 Approved July, 1963.

Ref. No. 2
 Douglas County Surveyors Record
 of Government Corners Renewed.

Bearings of reference trees are to the head of a spike
 driven into the bottom of a blaze near the base of the tree.

Distances are to side-center of the tree.



Lines between U.S. and Pvt. were blazed and yellow metal
 boundary tags were posted.

Bearings based on Solar Observation.

LEGEND

○ Monument found.

— True line blazed and posted.

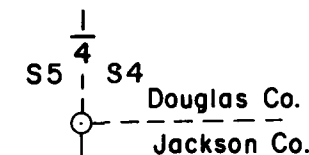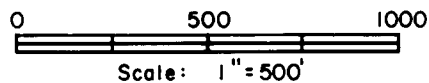

Ref. No. 2
 Fd. DCS BC
 4 BT's

Douglas Co.
 N 0° 11' 06" E. 2622.6'

Jackson Co.

