

SURVEY FOR DEED DESCRIPTION
 IN SEC. 15, T. 23S., R. 5W. W.M.
 FOR REYNALD RATTAI
 by BRUCE ROGERS
 SEPT., 1979
 1" = 100'

FILED ✓
 RECEIVED ✓


1979
 COUNTY SUR
 (COCLAR COUNT

COUNTY SURVEYORS FILE DATA
 DO NOT REMOVE FROM OFFICE

REGISTERED
 OREGON
 LAND SURVEYOR


Bruce R. Rogers

JULY 10, 1964
 BRUCE R. ROGERS
 660

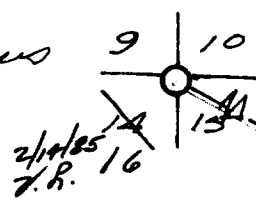

N 55° 34' 53" W 1939.80
 From M 42-96

- - FOUND 5/8" I.R. M 42-96
- - 5/8" Iron Rod set by Buyer & Seller for agreement lines.

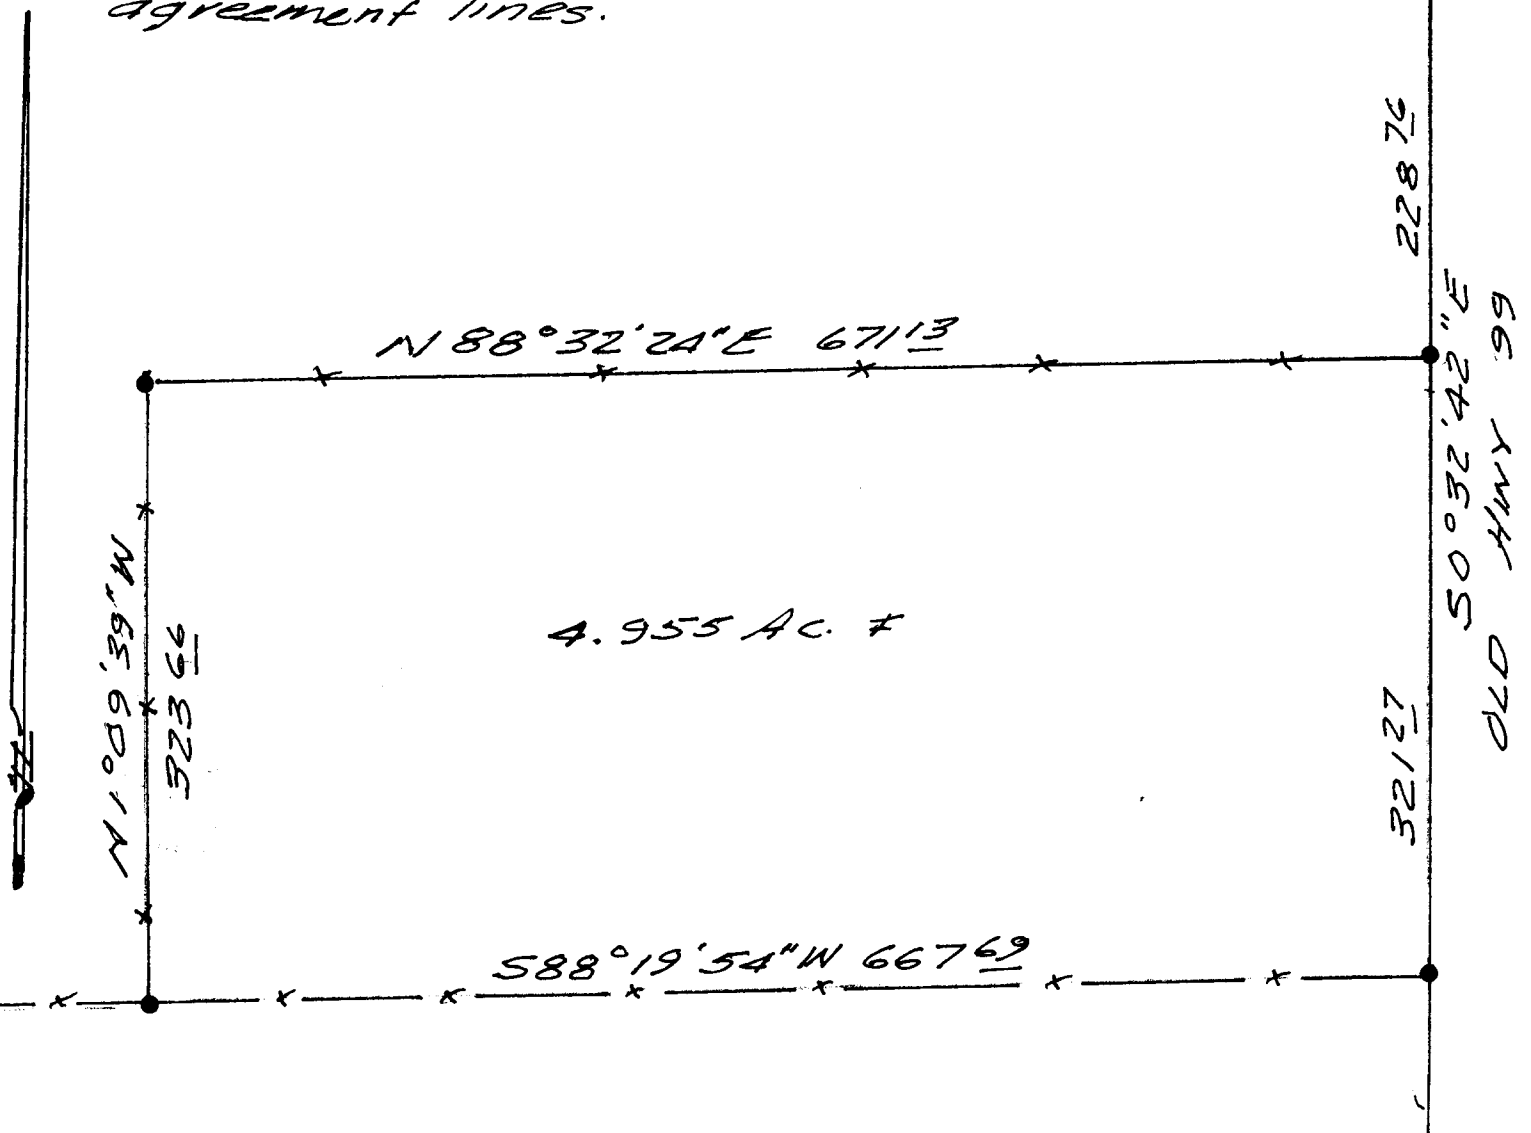

4.955 AC. ±