

**SURVEY FOR LLOYD BALLENTINE
 LOTS 5 & 13, "DE BOLT HOMESITES"
 IN SECTION 19, T25S, R5W, W.M.**

JULY 1979

SCALE: 1" = 200'

BY: BHW ENGINEERING & SURVEYING

FILED ✓

RECEIVED ✓

**COUNTY SURVEYORS FILE DATA
 DO NOT REMOVE FROM OFFICE**

AUG 8 1979

COUNTY SURVEYOR
 DOUGLAS COUNTY, ORE.


DESCRIPTION:

The northerly 10 feet of Lot 13, "DEBOLT HOMESITES" as recorded in Volume 7, Page 65 in the Plat Records of Douglas County, Oregon.

**REGISTERED
 PROFESSIONAL
 LAND SURVEYOR**

Romanso E. Ware

**OREGON
 NOV. 16, 1973
 ROMANSO E. WARE
 1005**

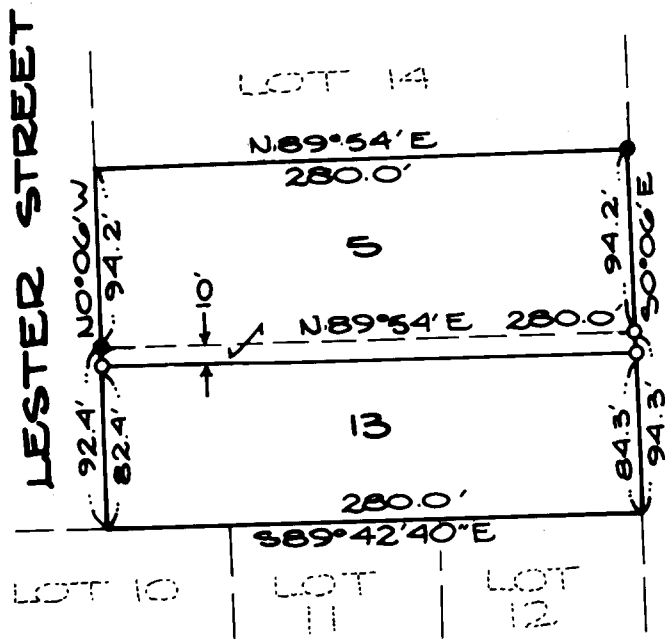

LEGEND

- - SET 5/8" IRON ROD
- - FD. 1/2" IRON PIPE



BASE BEARING PER PLAT OF DE BOLT HOMESITES