

Survey To Reset S.E. Cor. Lot 7, Blk 24 Riverside Addition To Roseburg, Oregon

IN SEC. 13, T27S, R6W, W.M.

FOR: JIM DEWAR 553 WEST ST. ROSEBURG, OREGON



BY: H.S. SURVEYING 1074 N.E. KNOLL ROSEBURG, OREGON
JAN. 6, 1980

FILED ϕ
RECEIVED ϕ

COUNTY SURVEYOR
DOUGLAS COUNTY, ORE

ϕ

COUNTY SURVEYORS FILE DATA
DO NOT REMOVE FROM OFFICE

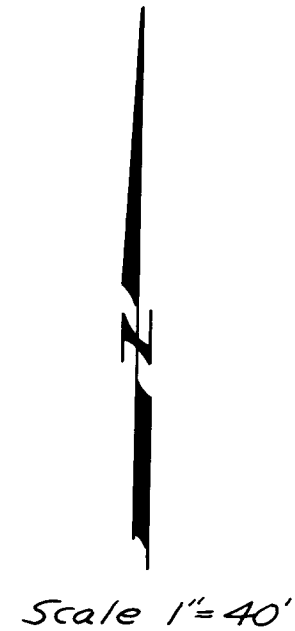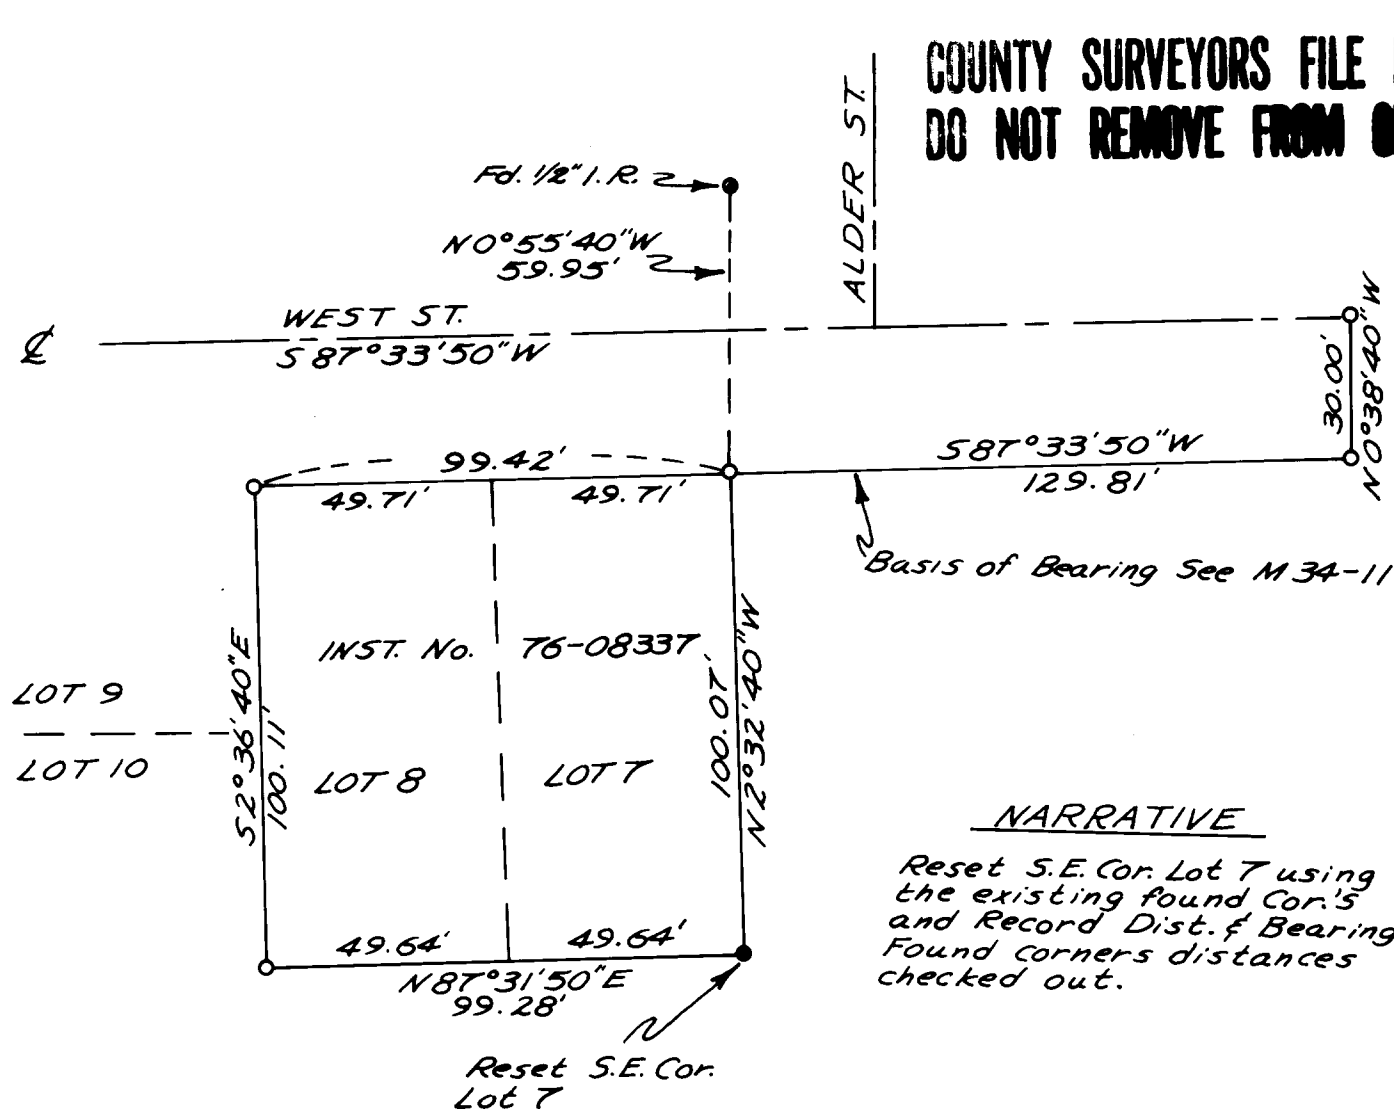

NARRATIVE

Reset S.E. Cor. Lot 7 using the existing found Cor.'s and Record Dist. & Bearing. Found corners distances checked out.

LEGEND

- — Set 5/8" Iron rod
- — Found 5/8" Iron rod

REGISTERED
PROFESSIONAL
LAND SURVEYOR

Harold V. Stockhoff

OREGON
JULY 14, 1978
HAROLD V. STOCKHOFF
1663