

M 96-20

FILED
RECEIVED *AD*

OREGON CORNER RESTORATION FORM

MAR 22 1984

Section 26 Township 20S Range 9W
County Douglas Date 2-13-84

COUNTY SURVEYOR
DOUGLAS COUNTY, ORE.

Corner Designation

South 4 Corner 26
Section 26
35

- Condition Report Only
- Not Found
- Renewed
- Unrecorded
- Surveyed In
- Referenced Out


Previous Renewals/Surveys, etc. Thomas A. Tillman and Joseph S. Gawron G.L.O. Survey in 1953-1954. Jelley and Bill Glenn Survey in 1968.

Monument(s) & Accessories Found: (Condition and Source)

Found 1953 G.L.O. Brass Cap set firmly in ground. Found steel fence post set by Jelley and Glenn in 1967 beside Brass Cap.
24" Fir, S36W, 8.0' (Scar Vis.), 1953 M. Rec. S36 3/4W, 7.9'
38" Fir, N45E, 6.1' (Scar Vis.), 1953 M. Rec. N45 1/2 E, 5.9'

Monument Detail

Sketch

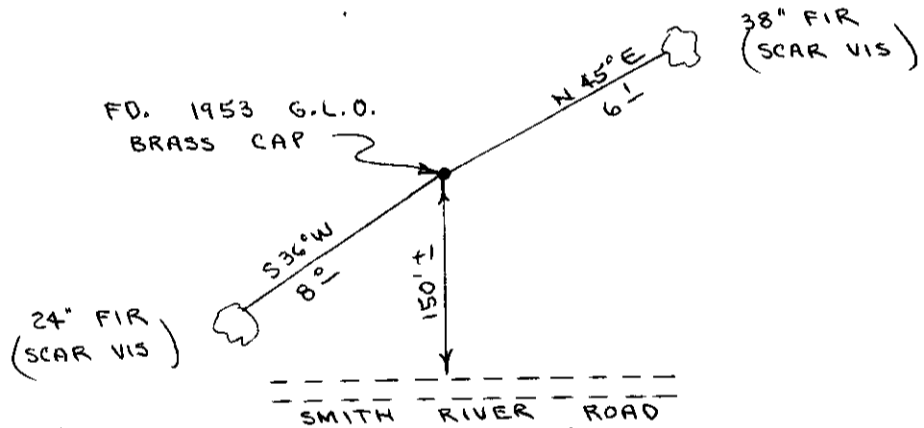

Monument Set (Procedures and Description)

New Accessories

aired survey attention sign to found metal fence post.

Location & Comments

Surveyor's Seal

Corner lies on flat ground about 150' North of Smith River Road. Corner is in 100-120 year old green timber.

Compass Declination 20 1/2


Firm/Agency Roberts Surveying inc.

Address 29 West 29th St. Eugene, Oregon 97405

Party Chief Les Roberts

Notes Ted Baker

Witness Stu Duce

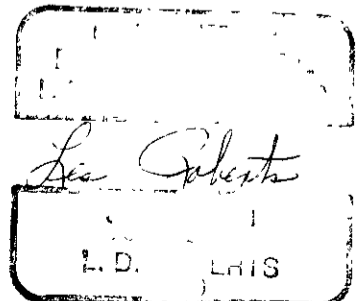

OK LEM

C.S. File No. 58/220-23b