

M 96-20

FILED
RECEIVED *BL*

OREGON CORNER RESTORATION FORM

MAR 22 1984

Section 26 Township 20S Range 24

COUNTY SURVEYOR
DOUGLAS COUNTY, ORE.

County Douglas Date 2-13-84

Corner Designation

East 1/4 Corner
Section 26 25-25

- Condition Report Only
- Not Found
- Renewed
- Unrecorded
- Surveyed In
- Referenced Out

Previous Renewals/Surveys, etc. Thomas A. Tillman and Joseph S. Gawron G.L.O. Survey in 1953-1954. Jelley and Bill Glenn Survey in 1967. County renewal #12 in 5-15-60

Monument(s) & Accessories Found: (Condition and Source)


Found 1954 G.L.O. Brass Cap set firmly in ground. Found steel fence post set by Jelley and Glenn in 1967 beside brass cap.

48" Fir Stump, N49W, 16.1' (Scribe Vis.), 1891 BT. Record N51W, 13.2'. This BT was rescribed by cadastral surveyor in 1967.

57" Fir Stump, N83E, 30.6' (Scar Vis.), 1891 BT. Record N83E, 29.7'. Both BT's set by cadastral surveyor in 1954 were destroyed by logging. I did not look for 12" Cedar BT set by Douglas County in 1969.

Monument Detail

Sketch

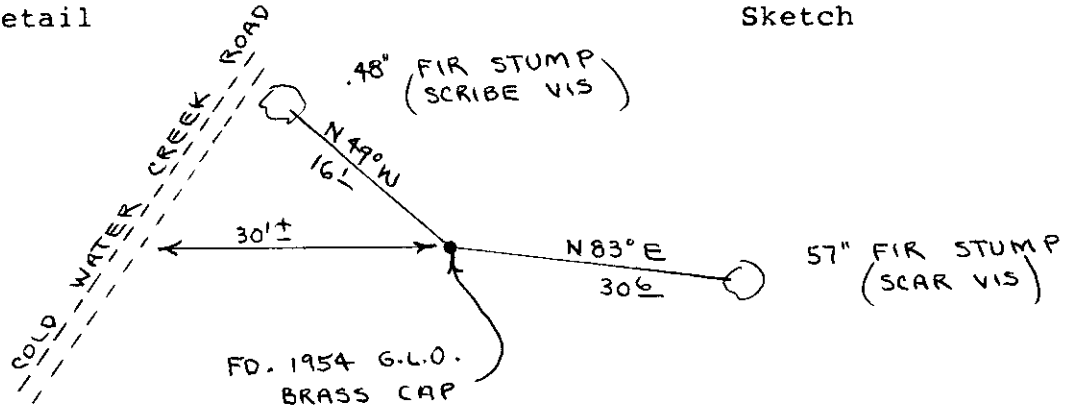

Monument Set (Procedures and Description)

New Accessories


wired survey attention sign to steel fence post.

Location & Comments

Surveyor's Seal

This corner lies on gentle South slope in old logging unit covered with 15-20 year old reproduction. Corner lies 30 feet Easterly of Cold Water Creek Road

Compass Declination 20 1/2
 Firm/Agency Roberts Surveying Inc.
 Address 29 West 29th St. Eugene, Oregon 97504
 Party Chief Les Roberts
 Notes Ted Baker
 Witness Stu Dice

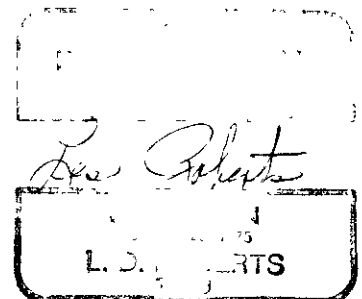

OK
Lm