

M 96-20

FILED
RECEIVED *ll*

OREGON CORNER RESTORATION FORM

MAR 22 1984

Section 26 Township 20S Range 2E

COUNTY SURVEYOR
DOUGLAS COUNTY, ORE.

County Douglas Date 2-16-84

Corner Designation

West $\frac{1}{4}$ Corner
Section 26 27 | 25

- Condition Report Only
- Not Found
- Renewed
- Unrecorded
- Surveyed In
- Referenced Out

Previous Renewals/Surveys, etc. Thomas A. Tillman and Joseph S. Gawron G.L.O. Survey in 1953-1954. Jelley and Bill Glenn Survey in 1967.

Monument(s) & Accessories Found: (Condition and Source)
Found 1953 G.L.O. Brass Cap set loosely in the ground. Found steel fence post set by Jelley and Glenn in 1967 beside brass cap.

18" Hemlock Stump, N69W, 31.0' (No Marks), 1953 BT.


Record N69W, 32.3'

33" Fir Stump, S33E, 24.4' (Scar Vis.), 1953 BT.

Record S31 $\frac{1}{2}$ E, 24.4'

Monument Detail

Sketch

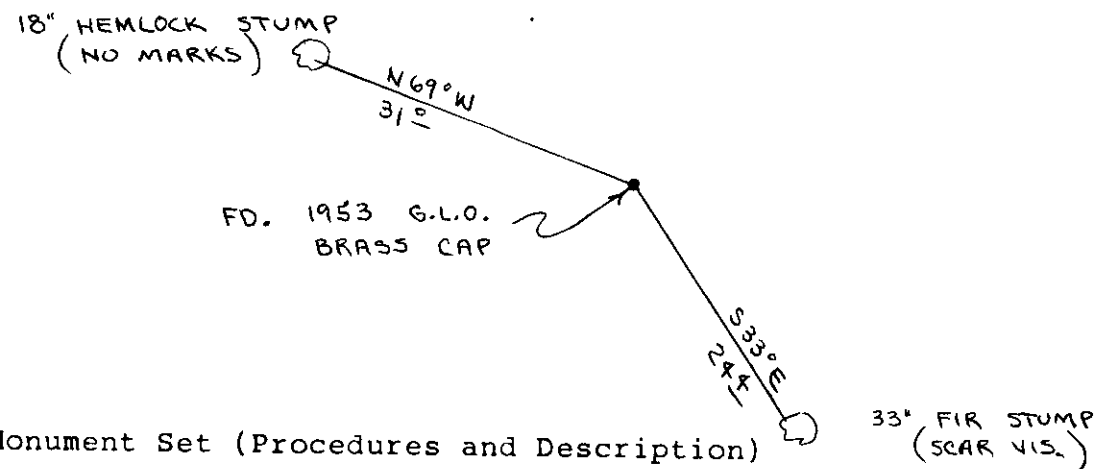

Monument Set (Procedures and Description)

New Accessories

I re-set 1953 G.L.O. Brass Cap 12" deeper in the ground. I also buried purple magnetic marker under 36" pipe. wired survey attention sign to steel fence post.

Location & Comments

Surveyor's Seal

Corner lies on large flat and is in a newly logged unit. Compass Declination 20 $\frac{1}{2}$
 Firm/Agency Roberts Surveying Inc.
 New reproduction is only 3 or 4 years old. Address 29 West 29th St. Eugene, Oregon 97405
 Party Chief Ted Baker
 Notes Stu Duce
 Witness Buzz Moisan

REGISTERED
PROFESSIONAL
LAND SURVEYOR

L. D. Roberts

OREGON
AUDITORS
L. D. ROBERTS
1039

ok
flm