

M 96-20

FILED
RECEIVED *BL*

OREGON CORNER RESTORATION FORM

MAR 22 1984

Section 26 Township 20S Range 9W

COUNTY SURVEYOR
DOUGLAS COUNTY, ORE.

County Douglas Date 2-15-84

Corner Designation

North $\frac{1}{4}$ Corner	23	<input checked="" type="checkbox"/> Condition Report Only
Section 26	26	<input type="checkbox"/> Not Found
		<input type="checkbox"/> Renewed
		<input type="checkbox"/> Unrecorded
		<input type="checkbox"/> Surveyed In
		<input type="checkbox"/> Referenced Out


Previous Renewals/Surveys, etc. Thomas A. Tillman and Joseph S. Gawron G.L.O. Survey in 1953-1954.

Monument(s) & Accessories Found: (Condition and Source)

Found 1954 G.L.O. Brass Cap set firmly in ground.
30" Fir Stump, S15E, 22.6' (Scribe Vis.), 1954 3T. Rec. S16E, 23.1'
54" Fir Stump, N71W, 16.0' (Scribe Vis.), 1954 3T. Rec. N68 $\frac{1}{2}$ W, 15.8'

Monument Detail

Sketch

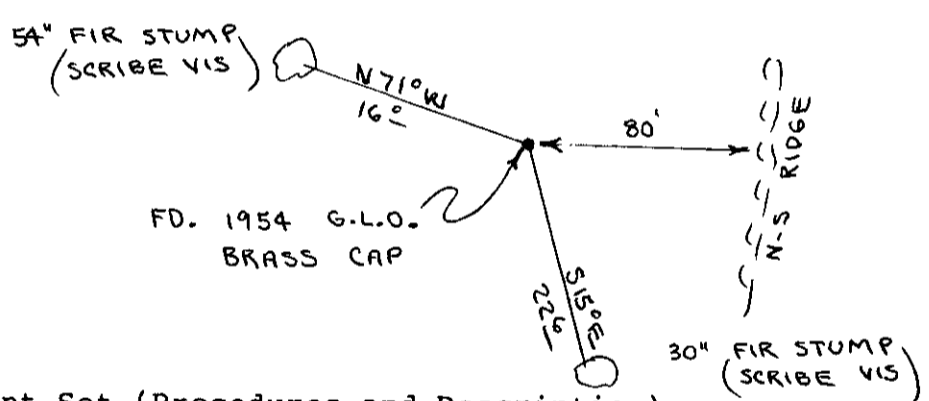

Monument Set (Procedures and Description)

New Accessories

Set metal fence post beside brass cap. wired survey attention sign to fence post.

Location & Comments

Surveyor's Seal

Corner lies on West slope about 80' west of North-South ridge. Corner is in old unit covered with 10-15 year old reprod.

Compass Declination 20 $\frac{1}{2}$

Firm/Agency Roberts Surveying

Address 29 West 29th St. Eugene, Oregon

Party Chief Les Roberts

Notes Ted Baker

Witness Stu Duce

REGISTERED
PROFESSIONAL
LAND SURVEYOR

Les Roberts

OREGON
AUGUST 22 1975
L. D. ROBERTS
1039

OK
Sam