

M 96-20

FILED
RECEIVED *BL*

OREGON CORNER RESTORATION FORM

MAR 22 1984

Section 26 Township 20S Range 9W
County Douglas Date 3-02-84

COUNTY SURVEYOR
DOUGLAS COUNTY, ORE.

Corner Designation

S.W. 1/16 Corner
Section 25




- Condition Report Only
- Not Found
- Renewed
- Unrecorded
- Surveyed In
- Referenced Out

Previous Renewals/Surveys, etc. None

Monument(s) & Accessories Found: (Condition and Source)

Monument Detail

Sketch

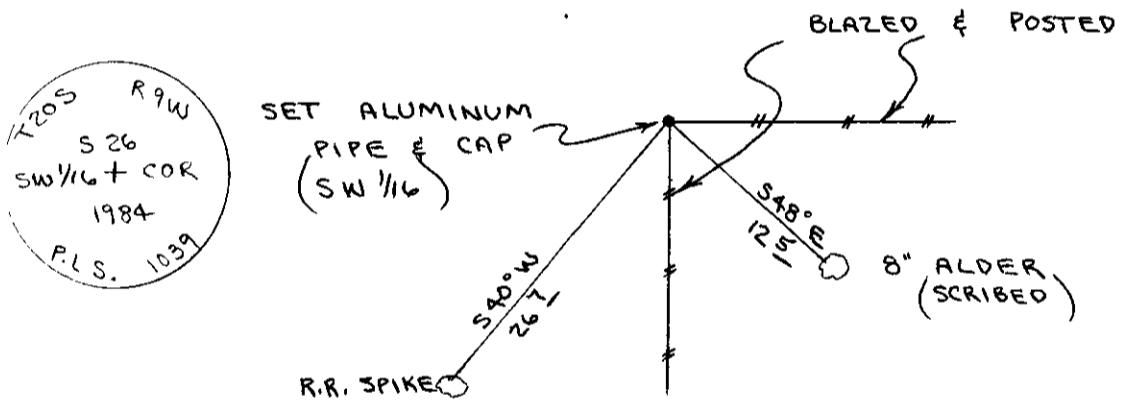

Monument Set (Procedures and Description)

Set 2" x 36" Aluminum pipe and cap. Cap stamped S-T-R, date and P.L.S. No. 1039. See filed survey for survey procedures.
Buried purple magnetic marker under 36" pipe.


New Accessories

8" Alder, S48E, 12.5' (Bark Scribed/Painted Red/Brass washer)
Set R.R. Spike in drill hole in rock face for bearing object.
S40W, 26.7' to spike.
Set metal fence post, with land survey monument sign wired to,
beside aluminum pipe.

Location & Comments

Corner lies on old slide area in small draw sloping North-westerly. Ground is very steep and rocky to North and West.
Compass Declination 20 1/2
Firm/Agency Roberts Surveying Inc.
Address 29 West 29th St. Eugene, Oregon 97405
Party Chief Ted Baker
Notes Stu Duce
Witness Buzz Moisan

Surveyor's Seal

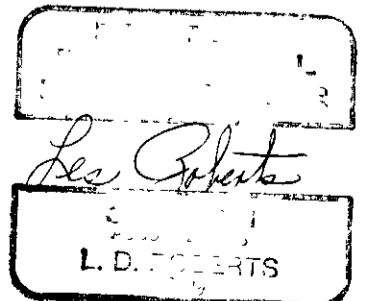

ok