

M 96-20

FILED  
RECEIVED *AS*

OREGON CORNER RESTORATION FORM

Section 26 Township 20S Range 9W


MAR 22 1984

County Douglas Date 3-02-84

COUNTY SURVEYOR  
DOUGLAS COUNTY, ORE.

Corner Designation

C.S. 1/16  
Corner  
Section 26

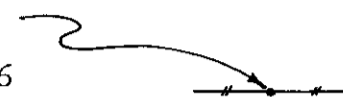


- Condition Report Only
- Not Found
- Renewed
- Unrecorded
- Surveyed In
- Referenced Out

Previous Renewals/Surveys, etc. None

Monument(s) & Accessories Found: (Condition and Source)

Monument Detail

Sketch

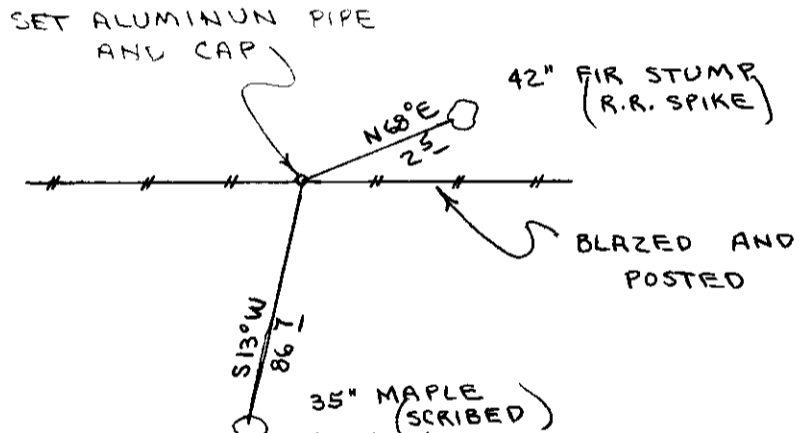

Monument Set (Procedures and Description)

Set 2" x 36" Aluminum pipe and cap. Cap stamped S-T-R, date and P.L.S. No. 1039. Buried purple magnetic marker under 36" pipe. See filed survey for survey procedures.

New Accessories

35" Maple, S13W, 86.7' (Scribed/Painted Red/Brass Washers)  
Set R.R. Spike in side of 42" Fir Stump. N68E, 2.5' to spike.  
Set metal fence post, with land survey monument sign wired to, beside aluminum pipe.

Location & Comments

Corner lies on East slope in old logging unit. Logging about 12-15 years old.

Compass Declination 20 $\frac{1}{2}$   
Firm/Agency Roberts Surveying Inc.  
Address 29 West 29th St. Eugene, Oregon 97405  
Party Chief Ted Baker  
Notes Stu Duce  
Witness Buzz Moisan

Surveyor's Seal

*Ted Roberts*

*OK flm*