

CERTIFIED RECORD OF LAND CORNER MONUMENTATION


History of original corner establishment:

Corner was established in 1902 by Homer D. Angel
General Land Office Contract #746

Records state:

Set a 3"X3" Fir post 24" in the ground marked
1/4 S17 on North and 20 on South from which

A 14" Fir bears N62°E 40 links marked 1/4 S17 BT
A 14" Fir bears S6°W 60 links marked 1/4 S20 BT

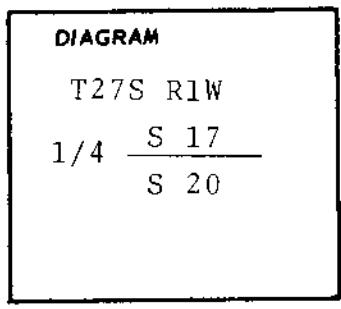

Description of corner evidence found:

Found Brass Cap on iron pipe as set by County Surveyors office in 1969 # 85

A 16" Fir S26.5°W 38.7 ft - good scar

Description of monument and accessories I established to perpetuate the original location of this corner

We scribed a 6" Fir N59°E 12.2 ft. scribed 1/4 S17 BT with Brass washer in BT face RLS 1005

HL

FILED

Ronald A. D... ..

APR 25 1980

Office of Surveyor County of Douglas
 State of Oregon, I hereby certify that the within instrument was filed in this office
 for record on the 25 day of April, 19 80 at 3:05 o'clock Pm. (signed)
Francis L. Ingram by Ronald A. D...
 (COUNTY OFFICIAL) (DEPUTY)

#158