

CERTIFIED RECORD OF LAND CORNER MONUMENTATION

History of original corner establishment:


Corner established in 1908 by William N. Gibb under General Land Office Contract #783

Records state

Set a Yew Post 4" square 24" in the ground marked 1/4 S7 on North & 18 on South face from which a

8" Hemlock bears N2°W 6 links marked 1/4 S7 BT

8" Hemlock bears S23°E 12 links marked 1/4 S18 BT

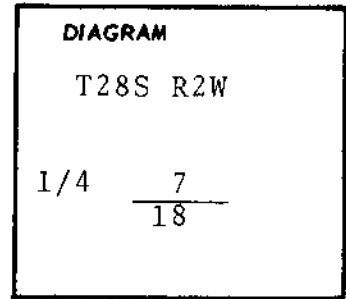

Description of corner evidence found:

Found aluminum Cap on Iron pipe as renewed by Thomas Shrum Jr. in 1962. #19

Found a 18" Hemlock N68°W 55.8 ft with visible scribe (set by Shrum)  
No original evidence left.

Description of monument and accessories established to perpetuate the original location of this corner

We scribed:

A 12" Hemlock S7°W 12.5 ft. scribed 1/4 S18 BT  
A 8" Hemlock N34°E 14.5 ft. scribed 1/4 S7 BT

Placed Brass washers in BT faces.

FILED  
APR 25 1980  
COUNTY SURVEYOR  
DOUGLAS COUNTY, ORE

REGISTERED  
PROFESSIONAL  
LAND SURVEYOR

*Ronald A. Finley*  
OFFICER  
RONALD A. FINLEY  
1954

Office of Surveyor County of Douglas  
State of Oregon, I hereby certify that the within instrument was filed in this office  
for record on the 25 day of April, 19 80, at 3:05 clock P.m., (signed)  
Francis L. Ingram by Ronald A. Finley  
(COUNTY OFFICIAL) (DEPUTY)

#112 ✓

c