

CERTIFIED RECORD OF LAND CORNER MONUMENTATION

History of original corner establishment:

Corner established in 1908 by William N. Gibb  
under General Land Office Contract #783

Records state:


Set a granite stone 6x12x6 11" in the ground  
with 5 notches on East and 4 notches on South, from  
which a

15" Cedar bears N 17 E 21 links marked T28S R2W  
S8 BT

5" Yew bears S51E 23 links marked T28S R2W S17 BT

4" Maple bears S42W 28 links marked T28S R2W S18 BT

8" Hemlock bears N81W 24 links marked T28S R2W S7 BT

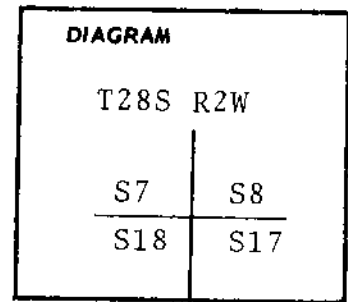

Description of corner evidence found:

Found aluminum cap on 1" iron pipe set by Thomas Shrum Jr. in 1962

A 12" Hemlock bears N80.5°W 14.6 ft. good face (original tree) # 20

A 25" Cedar N 17°E 15.5 ft good face " "

A 9" Yew S40.5°E 14.8 ft " " " "

Description of monument and accessories established to perpetuate the original location of this corner

We Scribed a 50" Douglas Fir S54°W 47.5 ft, scribed T28S R2W S18 BT

FILED  
RECORDED  
APR 25 1980  
COUNTY SURVEYOR  
DOUGLAS COUNTY, ORE.

REGISTERED  
PROFESSIONAL  
LAND SURVEYOR  
*Ronald A. Quimby*  
OREGON  
JULY 11, 1975  
RONALD A. QUIMBY  
1654

Office of Surveyor County of Douglas  
State of Oregon, I hereby certify that the within instrument was filed in this office  
for record on the 25 day of April, 19 80, at 3:05 o'clock P.m., (signed)  
Francis L. Ingram by Gregory C. Dittus  
(COUNTY OFFICIAL) (DEPUTY)