


CERTIFIED RECORD OF LAND CORNER MONUMENTATION

History of original corner establishment:

Corner was originally established by Joseph A. Ganong and John G. Collins, U. S. Cadastral Engineers, under a 1927 Dependant Resurvey. They set an iron post, 3 feet long, 1 inch. diameter, 28 inches in the ground with brass cap marked, "1/4 S31 1927" from which:

- A Fir, 14 ins. diam., bears S. 28° E., 44 lks. dist.
- A Fir, 8 ins. diam., bears N. 41° E. 6 lks. dist.

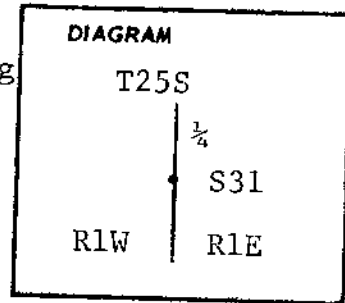

The corner was perpetuated in 1966 by V. R. Tracy, Douglas County Surveyor's Office, who reset the iron post in a mound of stone and rescribed both original bearing trees.


Description of corner evidence found:

1" X 36" iron post with a 2 1/2" brass cap laying on top of the ground. The monument was disturbed by two windthrown trees which pulled it out of the ground. The brass cap was marked:

U. S. General Land Office Survey

from which the original bearing trees:

- A 20" Douglas Fir, with healed blaze bears S. 28° E. 29.0 feet.
- A 12" Windthown Douglas Fir, with healed blaze bears N. 41° E., 4.0 feet.

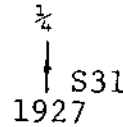

Description of monument and accessories established to perpetuate the original location of this corner

Reset the monument in its original position, 15 inches in the ground in a 3 ft. diameter mound of stone, 2 ft. high.

And marked a new bearing tree:

A 26" Douglas Fir, bears N. 62° E. 104.5 feet, marked: "1/4 S31 BT" on a double blaze with a brass washer stamped "LS 536" nailed into lower blaze.

**FILED**  
**RECEIVED** *jt*  
 SEP 22 1980  
**COUNTY SURVEYOR**  
**DOUGLAS COUNTY, ORE.**

**REGISTERED**  
**PROFESSIONAL**  
**LAND SURVEYOR**

*Glenn S. Baughman*

OREGON  
 JULY 14, 1961  
**GLENN S. BAUGHMAN**  
 536

Office of Surveyor ..... County of Douglas  
 State of Oregon .....  
 for record on the 22 day of September, 1980  
 Francis L. Ingram ..... by *Virginia A. Lauger*  
 (COUNTY OFFICIAL) (DEPUTY)

S-1W #150 X  
 S-1E #44 X