

DATE: 12-14-81

T31S R8W
CE 1/16 S 20

Condition Report Only
 Not Found
 Renewed
 Unrecorded
 Surveyed In
 Referenced Out

FILED
RECEIVED *JL*

DEC 18 1981

Previous Renewal #'s NONE

Monument(s) Found: (Condition and Source) NONE
COUNTY SURVEYOR
DOUGLAS COUNTY, ORE.

Accessories Found: (Condition and Source) NONE

REGISTERED
PROFESSIONAL
LAND SURVEYOR

Steven P. Ness


OREGON
JULY 14, 1967
STEVEN P. NESS
811

RENEWAL

Monument Set: (Procedure and Description) _____

SET $\frac{5}{8}$ " X 30" IPIN 2.1 FT IN GROUND W/ 2" AL. CAP

MKD:

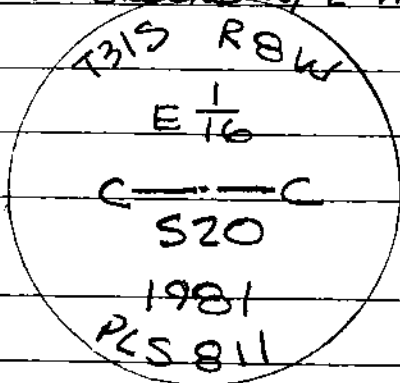

New Accessories: (Description) _____

30" D. FIR BEARS S87°W 11.95 (CE $\frac{1}{16}$ S20 BT)

32" D. FIR BEARS N30°E 6.3 (CE $\frac{1}{16}$ S20 BT)

Location and Comments: 20°E _____ Compass Declination

_____ Agency

_____ Party Chief

_____ Notekeeper

D. TAYLOR _____ Witnesses
