

GOVERNMENT CORNER RESTORATION FORM

Township 31S Range 6W Sec. 36 County Douglas

State Oregon Date Dec. 7, 1981 No. _____

Corner Designation

$\frac{1}{4} S \frac{525}{336}$

FILED
RECEIVED
DEC 11 1981
COUNTY SURVEYOR
DOUGLAS COUNTY, ORE

- Condition As Reported Only
- Not Found
- Renewed
- Unrecorded
- Surveyed In
- Referenced Out

Previous Renewals George Wenderoth, 1962

Monument(s) Found: (Condition and Source)

1" Iron Pipe, now buried & broken in half. Lower half in position & OK.

Accessories Found:

10" Yew BT, scribes visible, now uprooted & down, but in position, bears S77°E, 375 feet.
10" Maple BT, S78°W, 175 feet, Now Gone.

Note:

Corner was logged over several years ago.

#152 ✓


CS. 58/229-11

RENEWAL

Monument Set (Procedure and Description)

Set 2" x 32" Iron Pipe with
2 1/2" Brass Cap in place
of 1" Iron Pipe. (Reset 1"
Iron Pipe alongside Brass Cap.)

Monument Detail

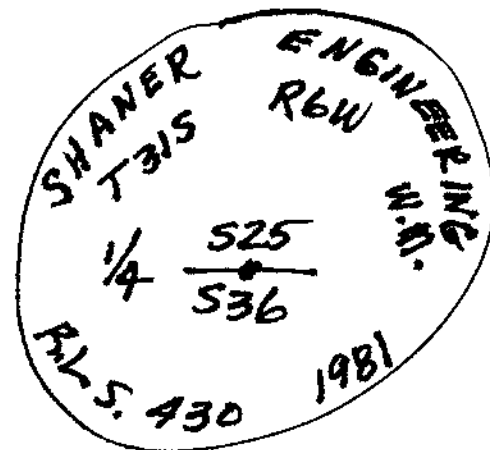

New Accessories

36" Douglas Fir Stump BT, I scribed "1/4 S ³⁶ BT"
bears S 84° E, 380 feet.

32" Douglas Fir Stump BT, I scribed "1/4 S 25 BT"
bears N 24° W, 251 feet.


Sketch of Monument, Accessories, and General Area

Location & Comments

Corner is 150 feet
South of Logging Road,
U.S. B.L.M. 31-6-26.0.

Comp. Declin. 20 1/2° E
Agency
Party Chief Mark Ramp
Notekeeper
Witnesses Brian Cameron
Bruce Shaner

Surveyor's Seal

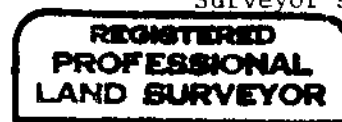

BA Shaner

