

Shaner Engineering, Inc.

PLANNING • SURVEYING • ENGINEERING
P. O. BOX 1430
ROSEBURG, OREGON 97470

FILED 433 S. E. MAIN
RECEIVED

NOV 15 1982

COUNTY SURVEYOR
DOUGLAS COUNTY, ORE

November 12, 1982

Francis L. Ingram, Douglas County Surveyor
County Courthouse
Roseburg, Oregon 97470

Dear Fritz:

Following is the description of a corner that I reestablished for International Paper Company recently. Please file it for public record.

B.A. Shaner
Bruce A. Shaner

RE-ESTABLISHED CORNER

At the one quarter section corner common to Sections 24 & 25, T23S, R7W, W.M., Douglas County, Oregon, I set a 2" x 32" galvanized iron pipe with a 2 1/2" Brass Cap marked "Shaner Engineering RLS 430, 1982, T23S, R7W, W.M., 1/4 S24, S25", with a steel fence post alongside, and from which brass cap a:


52" Douglas Fir stump, original BT, with probable scribe "B" cut from toe of stump, bears N46°W, 9.2 feet. Tag by Surveyor Wilfred Haines and U.S.B.L.M. BT tag both on this stump. This stump I rescribed "1/4S S24 BT".

52" Douglas Fir, original BT, bearing S15°E, 26.4 feet, now missing. Apparently removed by U.S.B.L.M. land clearing operation to the South for the progeny tree orchard.


Note: In 1962 when I was at this corner the NW BT had scribes visible and the SE BT was still in position.

36" Douglas Fir stump, I scribed "1/4S S25 BT" bears S79°W, 29.6 feet.

The corner is at the same location as the corner that I set a square wood stake in 1962. (See CS File M23-62). The wood stake was found on the ground near the corner. There is an East-West blazed line and timber cutting line thru the corner location. There is a cutting line 1/2 mile North on a bearing of N1°W as per 1962 Survey on the North-South Section Centerline.

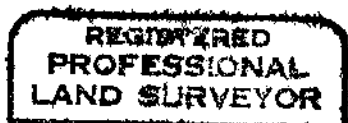

B.A. Shaner

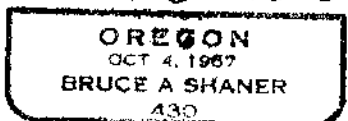

November 9, 1982

Bruce A. Shaner,
Professional Land Surveyor

& Mark Ramp, Instrument Man

#159 ✓

G. L. File No. 58/229-0
15