

Shaner Engineering, Inc.

PLANNING • SURVEYING • ENGINEERING
P. O. BOX 1430
ROSEBURG, OREGON 97470

December 6, 1982

SECTION CORNER COMMON TO SECTIONS 1 & 12, T27S, R6W, and SECTIONS 6 & 7, T27S, R5W, W.M.

On July 16, 1982, I tied into the above section corner and found:

a 1" iron pipe with a 2½" brass cap marked "COUNTY SURVEYORS OFFICE, S1, S12, T27S, R6W & S6, S7, R5W, 1967", from which a:

iron bolt with 1" square head sets alongside.

26" white oak BT with healed over upper face and rotted lower face bears, N46°W, 132.0 feet.

20" white oak BT with healed over face, bears N40°E, 76.5 feet.

5/8 " iron rod with aluminum cap stamped "BO 1" bears S45°E, 30.0 feet.

5/8" iron rod with aluminum cap stamped "BO 2" bears S45°W, 30.0 feet.


I set a steel fence post alongside the brass cap.

No trees were available to the South at a reasonable distance.

The corner lies in an open field approximately 64.0 feet south of Newton Creek.



B A Shaner

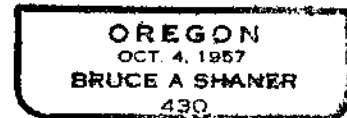

FILED
RECEIVED */s/*

DEC 7 1982

COUNTY SURVEYOR
DOUGLAS COUNTY, ORE.

#160 T27-5 ✓
#163 T27-6 ✓

G. L. E. No. 58/229-18

c