


CERTIFIED RECORD OF LAND CORNER MONUMENTATION


History of original corner establishment: The corner was originally established by William H. Byars, U. S. Deputy Surveyor in 1881 as recorded on Page 8026 of County Surveyor's Record, Douglas County, Oregon. The corner was perpetuated from original evidence by Donald Beck in a 1964 Dependent Resurvey as recorded on Page 13620 of said County Surveyor's Record.

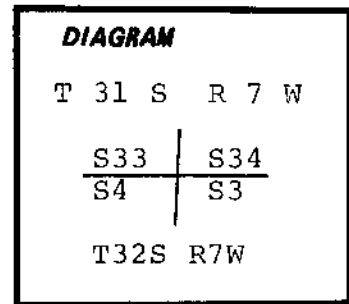

Description of corner evidence found: A 2 1/2" iron post, firmly set, projecting 4" above the ground with a 3" brass cap marked:

from which an original bearing tree:
 a 20" rotted and uprooted cedar snag, it's root hole bears N. 50° E., 16.5 feet.

and bearing trees by Beck in 1964:
 a 30" D. fir bears N. 17 3/4° E., 39.6 feet with a healed blaze.
 a 26" D. fir bears S. 59 3/4° E., 49.5 feet with a healed blaze.
 a 10" uprooted D. fir snag, its root hole bears S. 59° W., 54.1 feet.

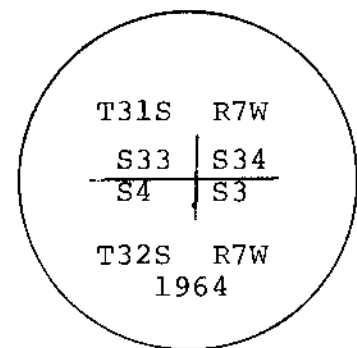

Description of monument and accessories established to perpetuate the original location of this corner:

new bearing trees:
 a 20" Incense cedar bears S. 82 1/2° W., 60.4 feet scribed "T32S R7W S4 BT" with a brass washer "LS 1941" nailed into lower blaze.
 a 8" chinquapin bears N. 15° W., 47.6 feet scribed "T31S R7W S33 BT" with a brass washer "LS 1941" nailed into lower blaze.

Distances to new bearing trees are measured to a nail in the root crown at the side and center of the tree.
 I painted 6" red bands around new bearing trees and all bearing tree faces red and attached bearing tree tags.

For: Allen & Gibbons Logging
 305 S. Main
 Canyonville, OR. 97417

By: Baughman Technical Services
 5157 N. Umpqua Hwy.
 Roseburg, OR. 97470

Nov. 28, 1983

**FILED
 RECEIVED**
 NOV 29 1983
**COUNTY SURVEYOR
 DOUGLAS COUNTY, ORE.**

REGISTERED
 PROFESSIONAL
 LAND SURVEYOR

Kristian J. DeGroot

OF OREGON
 JUL 27 1981
KRISTIAN J. DEGROOT
 1981

Office of... County Surveyor... County of... Douglas
 Oregon
 State of... I hereby certify that the within instrument was filed in this office
 for record on the 29th day of November, 1983
 Francis L. "Fritz" Ingram by *Virginia A. Saugen*
 (COUNTY OFFICIAL) (DEPUTY)

#116 T31-7A
 #113 T32-7X

File No. 58/229-21