



CERTIFIED RECORD OF LAND CORNER MONUMENTATION

History of original corner establishment: The corner was originally established by William H. Byers, U. S. Deputy Surveyor in 1881, as recorded on Page 8027 of County Surveyor's Record, Douglas County, Oregon. The corner was perpetuated from original evidence by Donald Beck in a 1964 Dependent Resurvey as recorded on Page 13621 of County Surveyor's Record, Douglas County, Oregon.

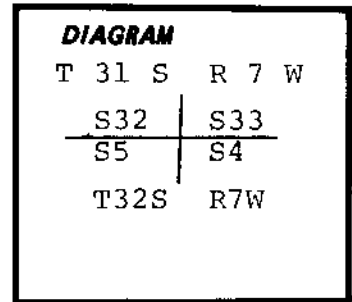

Description of corner evidence found: A 2 1/2" iron post, firmly set, projecting 2" above the ground with a 3" brass cap marked:

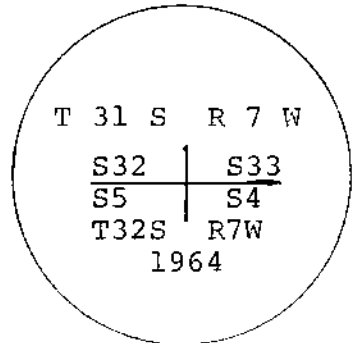

from which the original bearing trees:
 a 34" D. fir stump bears S. 36° E., 11.9 feet with bark scribe marks "T32S 7W S4 BT" visible.
 a 26" D. fir stump bears S. 12° W., 37.8 feet with bark scribe marks "T32S R7W S5 BT" visible, (Rec. 39.8 ft.)
 and bearing trees by Beck in 1964:
 a 19" D. fir stump bears N. 79 1/2° E., 58.1 feet with healed blaze.
 a 18" D. fir stump bears N. 54 1/2° W., 48.8 feet with healed blaze.
 and bearing trees by BLM in 1982 in a survey not yet approved:
 a 20" D. fir stump bears S. 40° E., 51.0 feet with scribe marks "T32S R7W S4 BT" visible, (Rec. 52.8 ft. from BT tag).
 a 8" cedar bears N. 58° W., 54.8 feet with scribe marks "T31S R7W S32 BT" visible.

Description of monument and accessories | established to perpetuate the original location of this corner:

a new bearing tree:
 a 8" tan oak bears N. 45 1/2° E., 120.9 feet, scribed "T31S R7W S33 BT" with a brass washer stamped "LS 1941" nailed into lower blaze.

I painted 6" red bands around new bearing trees and all bearing tree faces red and attached BT tags. Distance to new BT measured to a nail in root crown at the side and center of the tree.

For: Allen & Gibbons Logging
 305 S. Main
 Canyonville, OR. 97417

By: Baughman Technical Services
 5157 N. Umpqua Hwy.
 Roseburg, OR. 97470

Nov. 28, 1983

FILED
RECEIVED
 NOV 29 1983
COUNTY SURVEYOR
DOUGLAS COUNTY, ORE.

KRISTIAN D. INGRAM
 COUNTY SURVEYOR
 DOUGLAS COUNTY, OREGON
Kristian D. Ingram
 KRISTIAN D. INGRAM
 COUNTY SURVEYOR
 DOUGLAS COUNTY, OREGON

Office of..... County Surveyor..... County of..... Douglas
 Oregon
 State of....., I hereby certify that the within instrument was filed in this office
 for record on the 29th day of November..... 1983
 Francis L. "Fritz" Ingram..... by *Virginia A. Langen*
 (COUNTY OFFICIAL) (DEPUTY)

#114 T32-7X
 #117 T31-7X

File No. 50/229-23