



CERTIFIED RECORD OF LAND CORNER MONUMENTATION

History of original corner establishment: The corner was originally established by Donald Beck in a 1964 Dependent Resurvey as recorded on Page 13636 of County Surveyor's Record, Douglas County, Oregon.

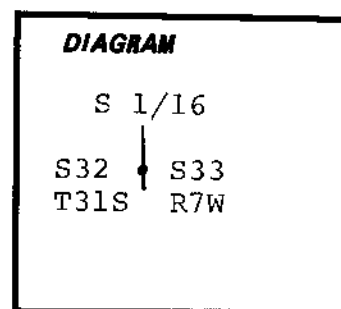

Description of corner evidence found: A 2 1/2" iron post, firmly set, projecting 2" above the ground with a 3" brass cap marked: from which bearing trees by Beck in 1964:
a 36" D. fir stump bears N. 31° E., 41.0 feet with healed blaze. (Rec. 41.6 ft.).
a 15" D. fir low cut stump bears N. 16 1/4° W., 61.2 feet with bottom of healed blaze visible on root crown. (Rec. 62.0 ft.)

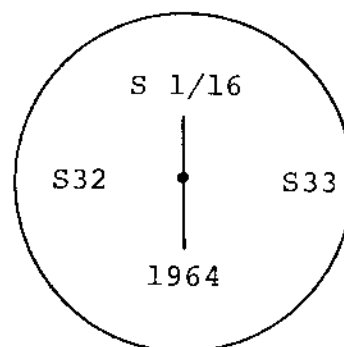

Description of monument and accessories I established to perpetuate the original location of this corner:

and new bearing trees:
a 8" tan oak bears N. 70 3/4° E., 25.6 feet, scribed "S 1/16 S33 BT" with a brass washer "LS 1941" nailed into lower blaze.
a 14" Madrona bears N. 57 1/2° W., 46.4 feet, bark scribed "S 1/16 S32 BT" with a brass washer "LS 1941" nailed into lower blaze.

I painted 6" red bands around new bearing trees and all bearing tree faces red and attached BT tags.
Distances to new BT's measured to a nail in root crown at the side and center of the tree.

For: Allen & Gibbons Logging
305 S. Main
Canyonville, OR. 97417

By: Baughman Technical Services
5157 N. Umpqua Hwy.
Roseburg, OR. 97470

Nov. 28, 1983

FILED
RECEIVED
NOV 29 1983
COUNTY SURVEYOR
DOUGLAS COUNTY, ORE

REGISTERED
PROFESSIONAL
LAND SURVEYOR

Kristian O. DeGroot

OREGON
JULY 17 1981
KRISTIAN O. DEGROOT
1941

Office of..... County Surveyor County of..... Douglas
State of..... Oregon....., I hereby certify that the within instrument was filed in this office
for record on the 29th day of November 19 83
Francis L. "Fritz" Ingram by *Angeline A. Baughman*
(COUNTY OFFICIAL) (DEPUTY)

C. S. File No. 58/229-2A