


CERTIFIED RECORD OF LAND CORNER MONUMENTATION

History of original corner establishment:

William M. Bushey under contract #620 dated June 17, 1893
Set 14"x10"x4" stone with "1/4" marked on N. face.
From which: 4" Laurel bears N23 1/2°E 33 1/2 lks "1/4 S BT"
26" Pine bears S23 3/4°E 125 lks.
"1/4 S BT"

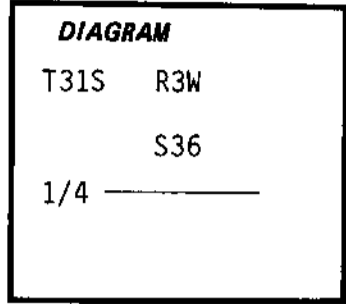

Description of corner evidence found:

4"x10"x14" stone with "1/4" plainly visible on north face from which a 45" Ponderosa Pine bears S23°-34' E 83.8 ft with a good scar

Description of monument and accessories I established to perpetuate the original location of this corner:


Set a 2"x30" aluminum pipe into the ground and constructed a mound of stones around it. I marked the attached 2 1/2" aluminum cap as shown.

From which: 26" D. Fir bears N71°-12'E 29.8 ft, scribed "1/4 S36, BT"
26" D. Fir bears N21°-35'E 11.5 ft, scribed "1/4 S36, BT"



with a brass washer marked "LS 866" nailed to each lower blaze.
Magnetic declination 21°E

FILED
RECEIVED *JK*
JUN 18 1980
COUNTY SURVEYOR
DOUGLAS COUNTY, ORE

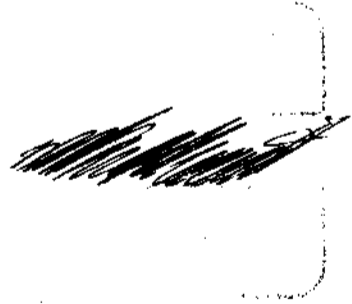

Office of... County Surveyor... County of... Douglas
State of... Oregon... I hereby certify that the within instrument was filed in this office
for record on the 18... day of... June... 1980
...Francis L. Ingram... by *Virginia A. Langen*
(COUNTY OFFICIAL) (DEPUTY)

#231 T 31-3 X
#197 T 32-3 X

File No. 58/229-25