


CERTIFIED RECORD OF LAND CORNER MONUMENTATION

History of original corner establishment:

Corner set by Mensch, U.S.G.L.O., 1906, and re-established by Douglas County, 1966.

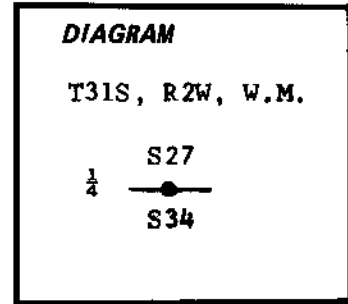

Description of corner evidence found:

Found 2 1/2" brass cap marked "County Surveyors Office, 1966, T31S, R2W, 1/4, S27, S34" from which a:

- Original Corner stone sets alongside, marked "1/4".
- 18" Douglas Fir Stump, original BT, scribes visible, bears N31°W, 11.9 feet.
- 20" Douglas fir stump, original BT, scribes visible, bears South, 16.5 feet.
- 15" Douglas fir snag, BT, scribes visible, bears S71°E, 34.3 feet.
- 19" Douglas fir snag, BT, scribes visible, bears N76°W, 3.0 feet.


Description of monument and accessories I established to perpetuate the original location of this corner:

~~None. -- No live trees available within reasonable distance.~~

BAS Aug. 15, '80

10" Douglas Fir I scribed "1/4 S34 BT" bears S.69°W., 21.6 feet.

I hereby certify the above corner was found on July 26, 1980.

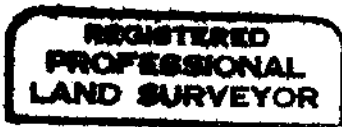

B A Shaner



Office of... Surveyor..... County of.. Douglas.....

State of... Oregon....., I hereby certify that the within instrument was filed in this office

for record on the... 14 day of... August... 1980

Francis L. Ingram

(COUNTY OFFICIAL)

by *Virginia A. Sawyer*

(DEPUTY)