


CERTIFIED RECORD OF LAND CORNER MONUMENTATION

History of original corner establishment:

Corner established by Nygren in 1977.

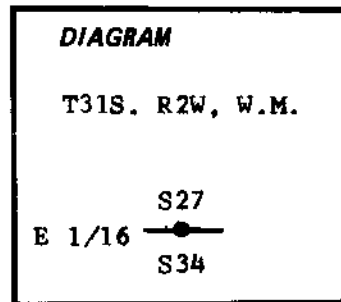


Description of corner evidence found:

Found 5/8" iron rod with 1 1/4" plastic cap marked "Nygren R S1035" from which a:
10" Cedar BT, scribes visible, bears N72°E, 21.44 feet.
8" Douglas Fir BT, scribes visible, bears N14°W, 16.10 feet.
(Record N20°W)

Description of monument and accessories established to perpetuate the original location of this corner:

At the corner point I set a 2 inch iron pipe with a 2 1/2 inch brass cap marked "T31S, R2W, W.M., E 1/16 S27, S34, 1980, RLS 430" and set Nygren's 5/8" iron rod alongside.

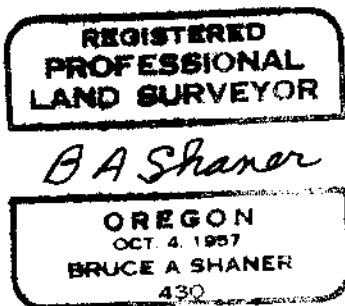

I hereby certify above corner monument was re-established as herein described on July 26, 1980.

Office of..... Surveyor..... County of..... Douglas.....
 Oregon.....
 State of....., I hereby certify that the within instrument was filed in this office
 for record on the 14 day of August, 1980
 Francis L. Ingram by Virginia A. Haugen
 (COUNTY OFFICIAL) (DEPUTY)