


CERTIFIED RECORD OF LAND CORNER MONUMENTATION

History of original corner establishment:

Corner was established by Nygren in 1977.

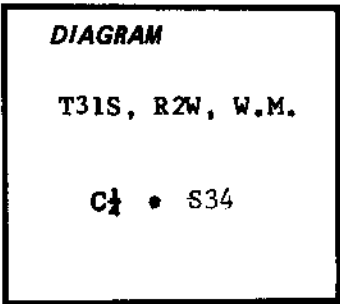


Description of corner evidence found:

Found a 5/8" iron rod with a 1 1/4" plastic cap marked "Nygren RS1035" from which a:  
 6" Hemlock BT (record yew), scribes visible bears N23°W, 7.2 feet.  
 6" Hemlock BT (record yew), scribes visible, bears S89°W, 15.1 feet. # 147  
 6" Hemlock BT (record yew, scribes visible, bears S39°E, 5.9 feet.

Description of monument and accessories I established to perpetuate the original location of this corner:

At the corner point I set a 2" iron pipe with a 2 1/2" brass cap marked "T31S, R2W, W.M., C 1/4, S34, RLS 430, 1980" and reset Nygren's 5/8" iron rod alongside.

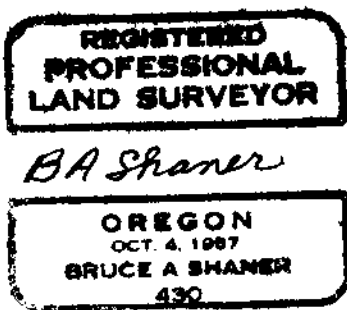

I hereby certify the above corner monument was re-established as herein described on July 22, 1980.

Office of... Surveyor..... County of... Douglas.....  
 State of... Oregon....., I hereby certify that the within instrument was filed in this office  
 for record on the... 14 day of... August....., 19... 80  
 Francis L. Ingram..... by... Virginia A. Langen  
 (COUNTY OFFICIAL) (DEPUTY)

#211