


CERTIFIED RECORD OF LAND CORNER MONUMENTATION

History of original corner establishment:

Corner was established by Nygren in 1977.

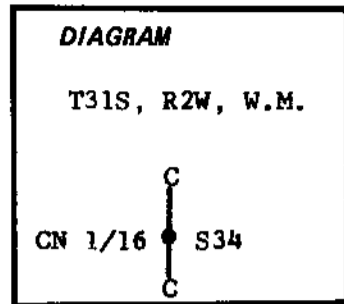

Description of corner evidence found:

Found 5/8" iron rod with 1 1/4" plastic cap marked "Nygren RS1035" from which a:  
10" White Fir BT, scribes visible, bears S65°W, 4.6 feet.  
18" White Fir BT, scribes visible, bears S26°E, 19.9 feet.

Description of monument and accessories I established to perpetuate the original location of this corner:

At the corner point I set a 2" iron pipe with a 2 1/2" brass cap marked "T31S, R2W, W.M., CN 1/16, S34, RLS 430 1980" and reset Nygren's 5/8" iron rod alongside.

REGISTERED  
PROFESSIONAL  
LAND SURVEYOR

*B A Shaner*

OREGON  
OCT. 4, 1987  
BRUCE A SHANER  
430

I hereby certify the above corner monument was re-established as herein described on July 22, 1980.

Office of.....Surveyor..... County of...Douglas.....

State of.....Oregon....., I hereby certify that the within instrument was filed in this office

for record on the...14... day of...August... 19...80

.....Francis L. Ingram..... by.....*Virginia A. Langer*.....

(COUNTY OFFICIAL)

(DEPUTY)